

3742  
F. H. WATTS Const.  
17455 Richmond Turnpike  
Milford, VA 22514

260'  
No wireguard



Commonwealth of Virginia  
Uniform Water Well Completion Report

Owner Anselmo + Norena Danzi  
Address 67 Richards Ferry Rd.  
Phone 236-2267  
Location Oakwood Est. Lot # 2

Tax Map ID 44-14-2  
VDH Permit SWP-00-409  
VWCB Permit \_\_\_\_\_  
VWCB ID \_\_\_\_\_  
County Stafford

Well Classification IIIA \_\_\_\_\_ IIIB  IIIC \_\_\_\_\_ IV \_\_\_\_\_  
\* Well Data \*

General Information  
Drilling Method A/R Rotary  
Depth to Bedrock 75'  
Static Water Level 30'  
Well Disinfected (Y or N) N

Date Completed 12/06/00  
Yield 10 (GPM)  
Stabilized Water Level \_\_\_\_\_  
Disinfectant Used \_\_\_\_\_

Total Depth of Well 300'  
Length of Test 1 hr.  
Natural Flow (Rate) N  
Amount Used \_\_\_\_\_

Casing From 1 1/2' To 10 5/8'  
Size 6 7/8" Material PVC  
Weight/Schedule \_\_\_\_\_

From \_\_\_\_\_ To \_\_\_\_\_  
Size 4 1/2" Material PVC  
Weight/Schedule 291 wall

From \_\_\_\_\_ To \_\_\_\_\_  
Size \_\_\_\_\_ Material \_\_\_\_\_  
Weight/Schedule \_\_\_\_\_

(80'-120') (140'-160') (150'-200') (220'-240') (250'-300')

Gravel Pack From \_\_\_\_\_ To \_\_\_\_\_  
Hole size \_\_\_\_\_  
" from \_\_\_\_\_ to \_\_\_\_\_ ft.

From \_\_\_\_\_ To \_\_\_\_\_  
" from \_\_\_\_\_ to \_\_\_\_\_ ft.

From \_\_\_\_\_ To \_\_\_\_\_  
" from \_\_\_\_\_ to \_\_\_\_\_ ft.

From 50' To 0  
Bore Hole Size 10" x 10 5/8"  
Type Bentonite E-2 sand  
Method pipette gravel from bottom to top

From 10 5/8' To 50'  
Bore Hole Size 10" x 10 5/8"  
Type ROCK CUTTINGS  
Method NATURAL CASE-IN

From \_\_\_\_\_ To \_\_\_\_\_  
Bore Hole Size \_\_\_\_\_  
Type \_\_\_\_\_  
Method \_\_\_\_\_

Water Zones or Screened Intervals  
From 102' To 164'  
Mesh Size \_\_\_\_\_ Diam \_\_\_\_\_  
From \_\_\_\_\_ To \_\_\_\_\_  
Mesh Size \_\_\_\_\_ Diam \_\_\_\_\_

From 270' To 272'  
Mesh Size \_\_\_\_\_ Diam \_\_\_\_\_  
From \_\_\_\_\_ To \_\_\_\_\_  
Mesh Size \_\_\_\_\_ Diam \_\_\_\_\_

From \_\_\_\_\_ To \_\_\_\_\_  
Mesh Size \_\_\_\_\_ Diam \_\_\_\_\_  
From \_\_\_\_\_ To \_\_\_\_\_  
Mesh Size \_\_\_\_\_ Diam \_\_\_\_\_

\* Use Data \*

Private Well Domestic  Agricultural \_\_\_\_\_ Industrial \_\_\_\_\_ Monitoring \_\_\_\_\_  
Public Well Community \_\_\_\_\_ Non Community \_\_\_\_\_

\* Abandonment Information \*

Bored or Dug Wells  
Casing Removed, Y or N? \_\_\_\_\_  
If Y, Depth to which casing was removed: \_\_\_\_\_  
Depth and Type of Fill: \_\_\_\_\_  
Source of Fill: \_\_\_\_\_  
Bentonite Plugs: From \_\_\_\_\_ to \_\_\_\_\_ From \_\_\_\_\_ to \_\_\_\_\_

Wells other than Bored Wells  
Casing removed, Y or N? \_\_\_\_\_  
Depth to which casing was removed: \_\_\_\_\_  
Applicable, depth(s), and type of gravel/sand fill: \_\_\_\_\_  
Source of gravel or sand: \_\_\_\_\_  
Cement: From \_\_\_\_\_ to \_\_\_\_\_ From \_\_\_\_\_ to \_\_\_\_\_

Method of permanently marking location:  
 Installed watertight top

NOT TO SCALE

Depth Description of Formation or Sediment


Remarks

WATER TIGHT CAP

0	20'	ORANGE CLAY
20'	50'	brown sandy clay
50'	75'	mica
75'	105'	soft brown rock
105'	162'	grey med. hard rock
162'	170'	brown med. hard rock making sediment
170'	270'	grey med. hard rock
270'	290'	green med. hard rock
290'	300'	grey hard rock

well making sediment  
so we screened

(Use additional Shoots if necessary)

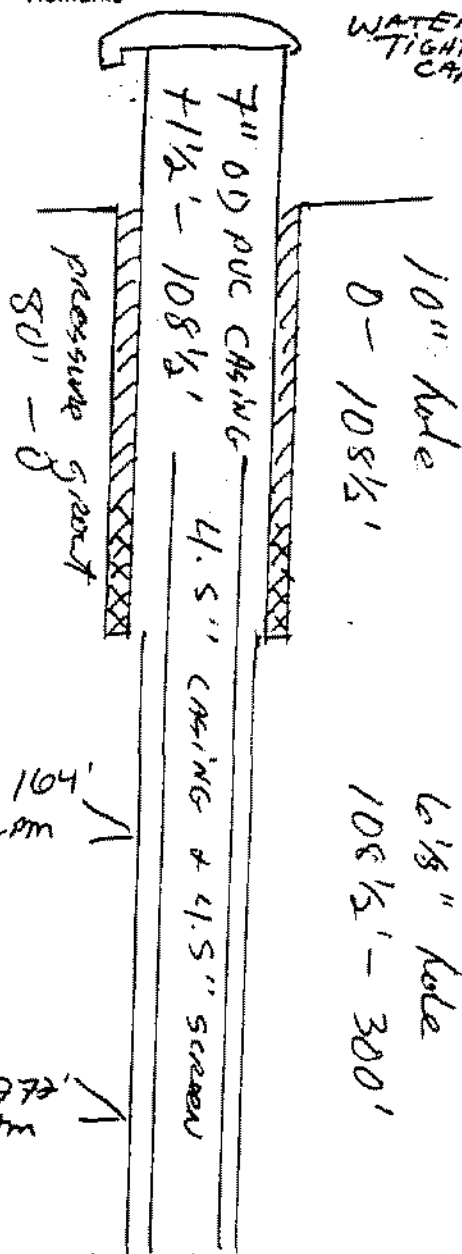

162'-164'  
5 GPM

270'-272'  
5 GPM

I hereby certify that the information contained here is true and that this well was installed and constructed in accordance with the permit and that the well complies with all applicable state and local regulations, ordinances and laws.

ARTESIAN WATER WELLS, INC.  
11412 GORDON RD  
P.O. BOX 22407  
VA 22407  
540-785-8163

Wade A. Dutton Jr.  
12/06/00 Representing A.W.W.I.

Contractors License Number 2705-046112