

**Commonwealth of Virginia
Uniform Water Well Completion Report**

Owner Donald R. Bateelor / For Sale

Tax Map ID 44-152D

Address P.O. Box 41275

VDH Permit SAW-95-260

Fredericksburg Va 22404

VWCB Permit _____

Phone 898-8378 786-5535 785-9170

VWCB ID _____

Location England Run (155 Sanford Drive)

County Stafford

173c 17N → 1/2 mi. on Sanford Rd → England Run Run on Right

8/1/95 Patton B. Wright

Well Classification IIIA IIIB ✓ IIIC IV

Approx 3/4 mi west of Inter. 670/England Run Well Data *

SFF

General Information
Drilling Method Auger Rotary
Depth to Bedrock 54'
Static Water Level 70'
Well Disinfected (Y or N) _____

Date Completed 6/3/96
Yield 6 (GPM)
Stabilized Water Level 260'
Disinfectant Used _____

Total Depth of Well 380
Length of Test approx 1 Hr.
Natural Flow (Rate) _____
Amount Used _____

Casing
From ±1 To 54
Size 6 1/4 Material P.V.C.
Weight/Schedule SDR 27

From _____ To _____
Size _____ Material _____
Weight/Schedule _____

From _____ To _____
Size _____ Material _____
Weight/Schedule _____

Gravel Pack
From _____ To _____

From _____ To _____

From _____ To _____

Hole size
10" from 0 to 50ft.

8 1/2" from 50 to 54ft.

6 1/8" from 54 to 380ft.

Grout
From 0 To 50+ 1/4

From _____ To _____

From _____ To _____

Bore Hole Size 10"

Bore Hole Size _____

Bore Hole Size _____

Type Bentonite

Type _____

Type _____

Method Pressure Grouting

Method _____

Method _____

Water Zones or Screened Intervals

From 150' To 151'

From _____ To _____

From _____ To _____

Mesh Size _____ Diam _____

Mesh Size _____ Diam _____

Mesh Size _____ Diam _____

From 343' To 344'

From _____ To _____

From _____ To _____

Mesh Size _____ Diam _____

Mesh Size _____ Diam _____

Mesh Size _____ Diam _____

* Use Data *

Private Well: Domestic Agricultural _____ Industrial _____ Monitoring _____

Public Well: Community _____ Non Community _____

* Abandonment Information *

Bored or Dug Wells
Casing Removed, Y or N? _____
If Y, Depth to which casing was removed: _____
Depth and Type of Fill: _____
Source of Fill _____
Bentonite Plugs: From _____ to _____ From _____ to _____

Wells other than Bored Wells
Casing removed, Y or N? _____
Depth to which casing was removed: _____
Applicable, depth(s), and type of gravel/sand fill: _____
Source of gravel or sand: _____
Cement: From _____ to _____ From _____ to _____

Method of permanently marking location: Installed watertight top
Suggest setting pump @ approx. 300 ft.

Donald R. Batchelor

England Run 152D (155 Sanford Drive)

Stafford

17 Nts L. on Sanford Drive → England Run Drive on Right
• Drillers Log


Depth

Description of Formation or Sediment

Remarks

0	10	Red Clay
10	30	Micaceous formation / Red
30	50	Micaceous formation / Brown
50	380	Blue Granite

DIAGRAM
(NOT TO SCALE)
+ 1 Ft.

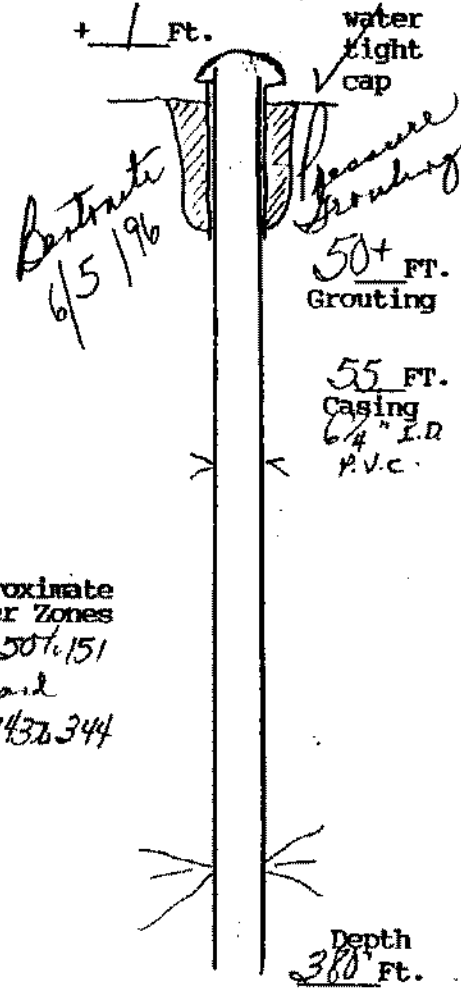

Approximate
Water Zones

150 to 151

and

343 to 344

(User additional Sheets if necessary)

I certify that the information contained here is true and that this well was installed and constructed in accordance with the permit and further that the well complies with all applicable state and local regulations, ordinances and laws.

Name JOHN L. DANIELSON, JR., INC.

Address 4616 HOOD DRIVE

FREDERICKSBURG, VIRGINIA 22408

Phone 540 (703) 898-6025 / 898-9355

Drillers Signature *Keith Danielson, Pres*

Date 6/5/94 Representing JOHN L. DANIELSON, JR., INC.

Virginia Contractors License Number CLASS A 2701 014084A H/H WVC