

COMMONWEALTH OF VIRGINIA

WATER WELL COMPLETION REPORT

• BWCM No. _____

(Certification of Completion/County Permit)

44-117B

State Water Control Board
P. O. Box 11143
2111 North Hamilton St.
Richmond, Va. 23230

County/City STAFFORD

County/City Stamp

• Virginia Plane Coordinates

N

E
Latitude & Longitude

N

W
• Topo. Map No. _____
• Elevation _____ ft.
• Formation _____
• Lithology _____
• River Basin _____
• Province _____
• Type Logs _____
• Cuttings _____
• Water Analysis _____
• Aquifer Test _____

• Owner W. S. Lambert
• Well Designation or Number SW-99-608
Address 3010 JERRY LN
Phone 703-491-5403
• Drilling Contractor R. L. CURTIS WELL DRILLING CO.
Address 5069 SUMERDUCK RD.
SUMERDUCK, VA 22742
Phone 540-439-8377

SWCB Permit _____
County Permit _____
Certification of inspecting official:
This well does _____ does not _____
meet code/low requirements.
S. _____
Date _____
For Office Use

Tax Map I.D. No. 44-117B
Subdivision KATHERINE B. PAYNE
Section _____
Block _____
Lot 13
Class Well: I _____ IIA _____
IIB _____ IIIA _____ IIIB _____
IIIC _____ IIID _____ IIIE _____

WELL LOCATION: _____ (feet/miles _____ direction) of _____
and _____ (feet/miles _____ direction) of _____
(If possible please include map showing location marked)

Date started 2/22/00 • Date completed 2/22/00 Type rig AIR

1. WELL DATA: New Reworked _____ Deepened _____
• Total depth 185 ft.
• Depth to bedrock 50 ft.
• Hole size (Also include reamed zones)
• 10 inches from 0 to 60 ft.
• 6 inches from 60 to 185 ft.
• _____ inches from _____ to _____ ft.
• Casing size (I.D.) and material
• 6 1/4 inches from 0 to 60 ft.
Material PLASTIC
Wt. per foot 4 or wall thickness 2 1/4 in.
• _____ inches from _____ to _____ ft.
Material _____
Wt. per foot _____ or wall thickness _____ in.
• _____ inches from _____ to _____ ft.
Material _____
Wt. per foot _____ or wall thickness _____ in.
• Screen size and mesh for each zone (where applicable)
• _____ inches from _____ to _____ ft.
• Mesh size _____ Type _____
• _____ inches from _____ to _____ ft.
• Mesh size _____ Type _____
• Gravel pack
• From _____ to _____ ft.
• From _____ to _____ ft.
• Grout
• From 0 to 50 ft., Type PRESSURE
• From _____ to _____ ft., Type _____

2. WATER DATA • Water temperature _____ OF
• Static water level (unpumped level-measured) 30 ft.
• Stabilized measured pumping water level 184 ft.
• Stabilized yield 12 gpm after 2 hours
Natural Flow: Yes _____ No _____ flow rate _____ gpm
Comment on quality _____
3. WATER ZONES: From _____ To _____
From _____ To _____ From _____ To _____
From _____ To _____ From _____ To _____
4. USE DATA:
Type of use: Drinking Livestock Watering _____
Irrigation _____ Food processing _____ Household _____
Manufacturing _____ Fire safety _____ Cleaning _____
Recreation _____ Aesthetic _____ Cooling or heating _____
Injection _____ Other _____
• Type of facility: Domestic Public water supply _____
Public institution _____ Farm _____ Industry _____
Commercial _____ Other _____
5. PUMP DATA: Type _____ • Rated H.P. _____
• Intake depth _____ • Capacity _____ at _____ head
6. WELLHEAD: Type well seal _____
Pressure tank _____ gal. Loc. _____
Sample tap _____ Measurement port _____
Well vent _____ Pressure relief valve _____
Gate valve _____ Check valve (when required) _____
Electrical disconnect switch on power supply _____
7. DISINFECTION: Well disinfected _____ yes _____ no _____
Date _____ Disinfectant used _____
Amount _____ Hours used _____
8. ABANDONMENT (where applicable) • yes _____ no _____
Casing pulled yes _____ no _____ not applicable _____
Plugging grout From _____ to _____ material _____

9. State law requires submitting to the Virginia State Water Control Board information about groundwater and wells for every well made in the State intended for water, or any other non-exempt well. This information must be submitted whether the well is completed, on standby, or abandoned. Information required includes: an accurately and completely prepared water well completion report, full data from any aquifer pumping tests, drill cuttings taken at ten foot intervals (unless exemption is secured), the results of any chemical analyses, and copies of any geophysical logs. Quarterly-pumpage and use reports are required from owners of public supply and industrial wells. County or State permits to drill may be required in some parts of the state. Some counties require submission of a water well completion report. The Virginia State Health Department requires a water well completion report for public supply wells.


10. DRILLERS LOG (use additional Sheets if necessary)

| DEPTH (feet) | | TYPE OF ROCK OR SOIL (color, material, fossils, hardness, etc.) | REMARKS (water, caving, cavities, broken, core, shot, (etc.)) |
|--------------|-----|--|--|
| From | To | | |
| 0 | 50 | BROWN SOIL | |
| 50 | 185 | SANDSTONE | |

11. Drilling Time (Min.)

12. DIAGRAM OF WELL CONSTRUCTION (with dimensions)

Well 185 FT
CAP 60 FT
GROUT 50 FT
Water tight CAP

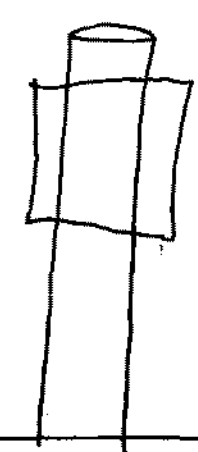

13. Well lot dedicated? _____ Size _____ ft. X _____ ft., Well house? _____
 Distance to nearest pollutant source _____ ft., Type _____
 Distance to nearest property line _____ ft., Building _____ ft.

14. WATER SERVICE PIPE: Checked under _____ p.s.i. for _____ minutes. Pipe size _____ inches, Material _____
 Installer _____
 Date _____

15. I certify that the information contained herein is true and correct and that this well and/or system has been installed and constructed in accordance with the requirements for well construction as specified in compliance with appropriate county or independent city ordinances and the laws and rules of the Commonwealth of Virginia.

State Water Control Board Regional Offices

Valley Reg. Off.
116 North Main Street
P. O. Box 268
Bridgewater, Va. 22812
703-828-2595

Piedmont Reg. Off.
4010 West Broad Street
P. O. Box 6616
Richmond, Va. 23230
804-257-1006

Southwest Reg. Off.
408 East Main Street
P. O. Box 476
Abingdon, Va. 24210
703-628-5183

Tidewater Reg. Off.
287 Pembroke Office Park
Suite 310 Pembroke No. 2
Va. Beach, Va. 23462
804-499-8742

West Central Reg. Off.
Executive Park
3312 Peters Creek Road
Roanoke, Va. 24019
703-982-7432

Northern Virginia Reg. Off.
5515 Cherokee Avenue
Suite 404
Alexandria, Va. 22312
703-750-9111

Signature Jerry Custer (Seal) Date 2/22/00
 (Well driller or authorized person) License No. 024220A