

Nash General Construction Inc

14874 Build America Drive

Woodbridge, Va 22191 Commonwealth of Virginia

1-703-491-7996 Uniform Water Well Completion Report

44-109-3

F 703-494-6349

Owner Robert A. Blacka Jr.

Address 14106 Robinson Court

Woodbridge, Va. 22191

Phone 1-703-490-0538

Location Holly Karnes Estate #3 (off Trustwood Rd)

Well Classification IIIA IIIB IIIC IV

\*17 → Rot 616 → Rot 652 \*Well Data\*

approx 2.2 mts on Right

Tax Map ID 458-R-36

VDH Permit WS-93-109

VWCB Permit \_\_\_\_\_

VWCB ID \_\_\_\_\_

County Stafford

5/13/93 Daniel J. Jozaly

5/13/93 J. Thompson

S.F.F.

**General Information**

Drilling Method Air Rotary

Depth to Bedrock 58

Static Water Level 50

Well Disinfected (Y or N) \_\_\_\_\_

Date Completed 3/8/94

Yield 8 (GPM)

Stabilized Water Level 200

Disinfectant Used \_\_\_\_\_

Total Depth of Well 240

Length of Test 1 Hr.

Natural Flow (Rate) \_\_\_\_\_

Amount Used \_\_\_\_\_

Casing From 1 To 58

Size 6 1/4 Material Steel

Weight/Schedule 188/13lbs per ft.

From \_\_\_\_\_ To \_\_\_\_\_

Size \_\_\_\_\_ Material \_\_\_\_\_

Weight/Schedule \_\_\_\_\_

From \_\_\_\_\_ To \_\_\_\_\_

Size \_\_\_\_\_ Material \_\_\_\_\_

Weight/Schedule \_\_\_\_\_

**Gravel Pack**

From \_\_\_\_\_ To \_\_\_\_\_

Hole size 10" from 0 to 50 ft.

GROUT From 0 To 50+

Bore Hole Size 10" 3/9/94

Type Bentonite

Method Pressure Grouting

From \_\_\_\_\_ To \_\_\_\_\_

Hole size 7 1/8" from 50 to 58 ft.

GROUT From \_\_\_\_\_ To \_\_\_\_\_

Bore Hole Size \_\_\_\_\_

Type \_\_\_\_\_

Method \_\_\_\_\_

From \_\_\_\_\_ To \_\_\_\_\_

Hole size 6 1/8" from 58 to 240 ft.

GROUT From \_\_\_\_\_ To \_\_\_\_\_

Bore Hole Size \_\_\_\_\_

Type \_\_\_\_\_

Method \_\_\_\_\_

**Water Zones or Screened Intervals**

From 230 To 231

Mesh Size \_\_\_\_\_ Diam \_\_\_\_\_

From \_\_\_\_\_ To \_\_\_\_\_

Mesh Size \_\_\_\_\_ Diam \_\_\_\_\_

From \_\_\_\_\_ To \_\_\_\_\_

Mesh Size \_\_\_\_\_ Diam \_\_\_\_\_

**\* Use Data \***

Private Well: Domestic

Agricultural \_\_\_\_\_

Industrial \_\_\_\_\_

Monitoring \_\_\_\_\_

Public Well: Community \_\_\_\_\_

Non Community \_\_\_\_\_

**\* Abandonment Information \***

**Bored or Dug Wells**

Casing Removed, Y or N? \_\_\_\_\_

If Y, Depth to which casing was removed: \_\_\_\_\_

Depth and Type of Fill: \_\_\_\_\_

Source of Fill \_\_\_\_\_

Bentonite Plugs: From \_\_\_\_\_ to \_\_\_\_\_ From \_\_\_\_\_ to \_\_\_\_\_

**Wells other than Bored Wells**

Casing removed, Y or N? \_\_\_\_\_

Depth to which casing was removed: \_\_\_\_\_

Applicable, depth(s), and type of gravel/sand fill: \_\_\_\_\_

Source of gravel or sand: \_\_\_\_\_

Cement: From \_\_\_\_\_ to \_\_\_\_\_ From \_\_\_\_\_ to \_\_\_\_\_

Method of permanently marking location: \_\_\_\_\_

Installed watertight top

Suggest setting pump @ approx. 220 ft.

Nash Construction

Robert Black

Holly Rains #3

Stafford

\*17 → Cor 616 → Cor 652 Drillers Log\*  
 approx 2.2 Miles on 652 / on Right


Depth

Description of Formation or Sediment

Remarks

0	10	Sandy Red Clay
10	30	Micaceous formation / Red
30	50	Micaceous formation / Brown
50	58	Soft Brown Shale
58	240	Black Granite

DIAGRAM  
(NOT TO SCALE)

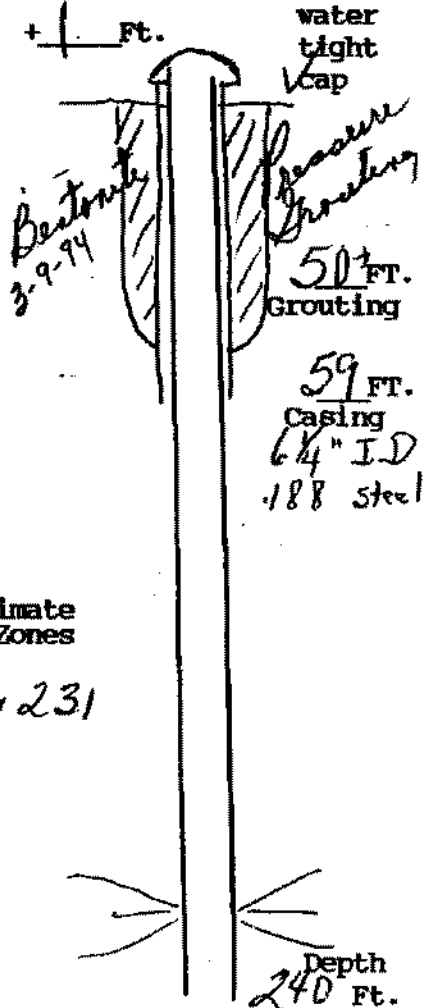

Approximate  
Water Zones

230 & 231

(User additional Sheets if necessary)

I certify that the information contained here is true and that this well was installed and constructed in accordance with the permit and further that the well complies with all applicable state and local regulations, ordinances and laws.

Name JOHN L. DANIELSON, JR., INC.  
 Address 4616 HOOD DRIVE  
FREDERICKSBURG, VIRGINIA 22408  
 Phone (703) 898-6025 / 898-9355

Drillers Signature [Signature]  
 Date 3/9/94 Representing JOHN L. DANIELSON, JR., INC.

Virginia Contractors License Number CLASS A 2701 014084A H/H WWC

