

Commonwealth of Virginia  
Uniform Water Well Completion Report

Owner Stafford Nursery  
Address 544 Tanslow Rd.  
Stafford VA  
Phone (540) 654-5410  
Location same as above

Tax Map ID 45-133  
VDH Permit W-99-588  
WVCB Permit \_\_\_\_\_  
WVCB ID \_\_\_\_\_  
County Stafford

\* Well Data \*

General Information

Drilling Method Air Rotary  
Depth to Bedrock 65'  
Static Water Level 40'  
Well Disinfected (Y or N) N

Date Completed 8/17/99  
Yield 30+ (GPM)  
Stabilized Water Level \_\_\_\_\_  
Disinfectant Used \_\_\_\_\_

<sup>drilled</sup> Total Depth of Well 300'  
Length of Test 1 hr.  
Natural Flow (Rate) N  
Amount Used \_\_\_\_\_

Casing  
From +1 1/2' To 71 1/2'  
Size 6 1/4" ID Material PVC  
Weight/Schedule 3.491 # per ft.  
.250 wall

From 180' To 160'  
Size 4.3" ID Material PVC  
Weight/Schedule 2.788 # per ft.  
.291 wall

From 60' To 40'  
Size 4.3" ID Material PVC  
Weight/Schedule 2.788 # per ft.  
.291 wall

Gravel Pack

From \_\_\_\_\_ To \_\_\_\_\_

From \_\_\_\_\_ To \_\_\_\_\_

From \_\_\_\_\_ To \_\_\_\_\_

Grout

From 50' To 0  
Bore Hole Size 10" x 7 1/2"  
Type Aqua Guard Bentonite  
Method pressure grout from bottom to top

From 71 1/2' To 50'  
Bore Hole Size 10" x 7 1/2"  
Type back fill cuttings  
Method from drill

From \_\_\_\_\_ To \_\_\_\_\_  
Bore Hole Size \_\_\_\_\_  
Type \_\_\_\_\_  
Method \_\_\_\_\_

Water Zones or Screened Intervals

From 160' To 60'  
Mesh Size .20 Diam 4 1/2"  
From \_\_\_\_\_ To \_\_\_\_\_  
Mesh Size \_\_\_\_\_ Diam \_\_\_\_\_

From \_\_\_\_\_ To \_\_\_\_\_  
Mesh Size \_\_\_\_\_ Diam \_\_\_\_\_  
\* Use Data \*

Private Well: Domestic  Agricultural \_\_\_\_\_ Industrial \_\_\_\_\_ Monitoring \_\_\_\_\_  
Public Well: Community \_\_\_\_\_ Non Community \_\_\_\_\_

\* Abandonment Information \*

Bored or Dug Wells

Casing Removed, Y or N? \_\_\_\_\_  
If Y, Depth to which casing was removed: \_\_\_\_\_  
Depth and Type of Fill: \_\_\_\_\_  
Source of Fill \_\_\_\_\_  
Bentonite Plugs: From \_\_\_\_\_ to \_\_\_\_\_ From \_\_\_\_\_ to \_\_\_\_\_


Wells other than Bored Wells  
Casing removed, Y or N? \_\_\_\_\_  
Depth to which casing was removed: \_\_\_\_\_  
Applicable, depth(s), and type of gravel/sand fill: \_\_\_\_\_  
Source of gravel or sand: \_\_\_\_\_  
Cement: From \_\_\_\_\_ to \_\_\_\_\_ From \_\_\_\_\_ to \_\_\_\_\_

Method of permanently marking location: \_\_\_\_\_

\* Drillers Log \*

Depth	Description of Formation or Sediment	Remarks
0-65'	overburden	
65'-300'	areas of broken gravel, quartz, sandstones, and some shales mixed consistently throughout the drilling process.	

Note: (We lost the last 120' of hole (300'-180') & informed customer we may have to bring in bigger screens to drill the well down further)

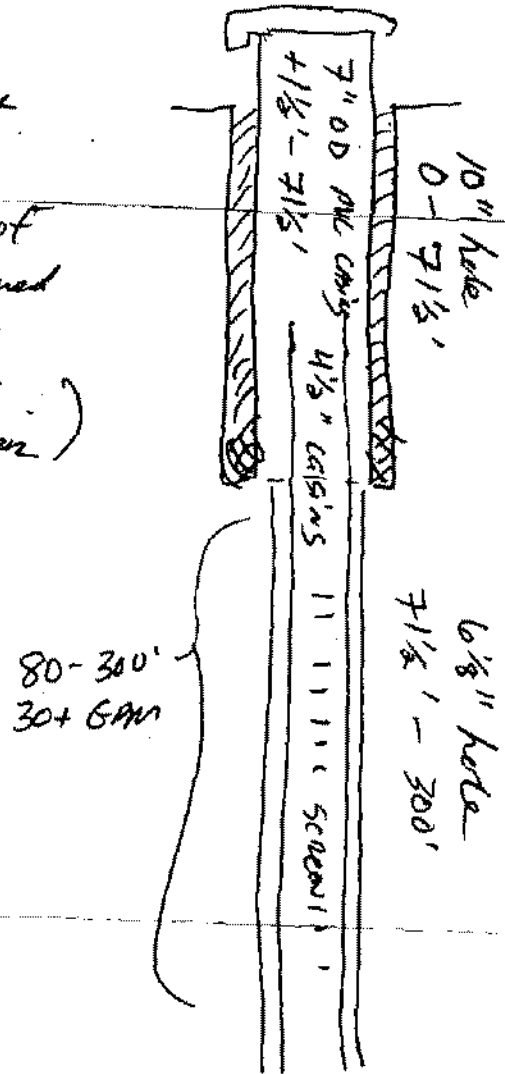

(User additional Sheets if necessary)

I certify that the information contained here is true and that this well was installed and constructed in accordance with the permit and I further that the well complies with all applicable state and local regulations, ordinances and laws.

Name ARTESIAN WATER WELLS, INC.  
 Address 17412 GORDON RD.  
FREDERICKSBURG, VA 22407  
 Phone (540) 785-8163  
 Drillers Signature Wayne M. Smith  
 Date 8/17/99 Representing AWWI  
 Virginia Contractors License Number 2705-046112