


Arnold De Maria
Adjoys Dequod Air Park
Stafford 626

Drillers Log

Depth	Description of Formation or Sediment	Remarks
0 10	yellow sand & gravel	
10 70	Black sand & shells	
70 110	Grey clay	
110 140	Grey Sand Clay	
140 165	Gray sand & gravel	
165 173	Grey clay	
173 187	Sandstone	
187 190	Grey clay	

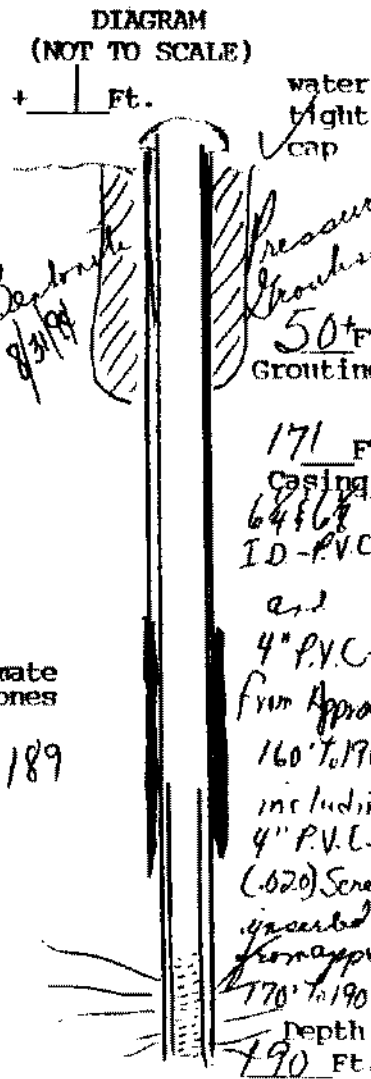

Approximate Water Zones

174 to 189

(User additional Sheets if necessary)

I certify that the information contained here is true and that this well was installed and constructed in accordance with the permit and further that the well complies with all applicable state and local regulations, ordinances and laws.

Name JOHN L. DANIELSON, JR., INC.
 Address 4616 HOOD DRIVE
FREDERICKSBURG, VIRGINIA 22408
 Phone (703) 898-6625 / 898-9355

Drillers Signature Arnold De Maria, Pres
 Date 7/31/94 Representing JOHN L. DANIELSON, JR., INC.

Virginia Contractors Licence Number CLASS A 2701 014084A II/II WVC