

Home
1200 1687
Stafford Va - 22555-1687
720-115751

Commonwealth of Virginia
Uniform Water Well Completion Report

Owner Edward M. Burrage
Address 3348 Hollingswood Drive
Woodbridge, Va 22193
Phone _____
Location Cross Corner #676 19#
3/4 Miles N of Inter of #1 & 676 - Cross Corner
Well Classification IIIA IIIB IIIC IV
* Well Data *

Tax Map ID 46-10P
VDH Permit SW-94-119
VWCB Permit _____
VWCB ID _____
County Stafford
5/18/94 Daniel Groeschel
5/23/94 TT Thompson
SFF

General Information
Drilling Method Air Rotary
Depth to Bedrock _____
Static Water Level 60'
Well Disinfected (Y or N) _____

Date Completed 2/14/97
Yield 25 (GPM)
Stabilized Water Level 160'
Disinfectant Used _____

Total Depth of Well 220'
Length of Test approx 1 HR
Natural Flow (Rate) _____
Amount Used _____

Casing
From 1 To 119
Size 6 1/4 Material Steel
Weight/Schedule 188/13 lb. per ft.

From 40 To 200
Size 4" Material P.V.C.
Weight/Schedule Sch. 40

From _____ To _____
Size _____ Material _____
Weight/Schedule _____

Gravel Pack
From _____ To _____
Hole size 10" from 0 to 55 ft.
Grout _____
From 0 To 50'
Bore Hole Size 10" 2/14/97
Type Bentonite
Method Pressure Grouting

From _____ To _____
Hole size 7 1/8" from 55 to 119 ft.
From _____ To _____
Bore Hole Size _____
Type _____
Method _____

From _____ To _____
Hole size 6 1/8" from 119 to 220 ft.
From _____ To _____
Bore Hole Size _____
Type _____
Method _____

Water Zones or Screened Intervals
From 200 To 220
Mesh Size 016 Diam 4" (P.V.C.)

Water zone
From 200 To 215
Mesh Size _____ Diam _____

From _____ To _____
Mesh Size _____ Diam _____

* Use Data *

Private Well: Domestic Agricultural _____ Industrial _____ Monitoring _____
Public Well: Community _____ Non Community _____

* Abandonment Information *

Bored or Dug Wells
Casing Removed, Y or N?: _____
If Y, Depth to which casing was removed: _____
Depth and Type of Fill: _____
Source of Fill _____
Bentonite Plugs: From _____ to _____ From _____ to _____

Wells other than Bored Wells
Casing removed, Y or N? _____
Depth to which casing was removed: _____
Applicable, depth(s), and type of gravel/sand fill: _____
Source of gravel or sand: _____
Cement: From _____ to _____ From _____ to _____


Method of permanently marking location:
 Installed watertight top
Suggest setting pump @ approx. 180 ft.
Well pumped 15 GPM @ 180' on 2/14/97

Arthur
Crane Corner
Stafford
 off U.S. # 676

* Drillers Log *


Depth Description of Formation or Sediment Remarks

0	10	Red Clay
10	30	yellow Sand
30	110	Sand & Gravel
110	200	Blue Clay
200	215	Grey sand - water zone
215	220	sandstone

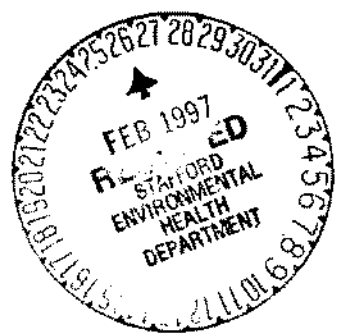

Approximate Water Zones
 205-215

DIAGRAM (NOT TO SCALE)
 + / Ft.

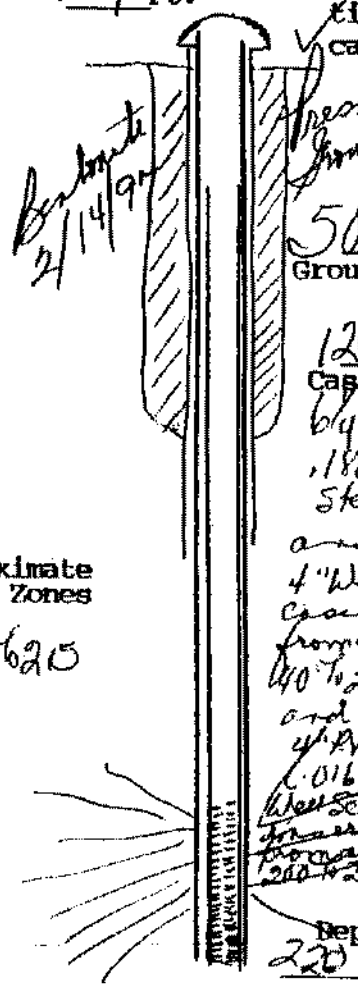

(User additional Sheets if necessary)

I certify that the information contained here is true and that this well was installed and constructed in accordance with the permit and further that the well complies with all applicable state and local regulations, ordinances and laws.

Name JOHN L. DANIELSON, JR., INC.
 Address 4616 HOOD DRIVE
FREDERICKSBURG, VIRGINIA 22408
 Phone 540 (703) 898-6025 / 898-9355

Drillers Signature John L. Danielson, Pres
 Date 2/14/97 Representing JOHN L. DANIELSON, JR., INC.

Virginia Contractors License Number CLASS A 2701 014084A II/II WNC