

Colbert/rou/ju

Wells
Wells Company
Highway # 303A
VA 22554
PA 658-9118

Commonwealth of Virginia
Uniform Water Well Completion Report

David & Jennifer Gibson
3220 Webster Drive
Stafford, VA 22554
Phone *541-46225*
Location *Victoria, Woodway # 6*

Tax Map ID *46L-2-6*
VDH Permit *SWP-01-519*
VWCB Permit _____
VWCB ID _____
County *Stafford*
10/22/01 Gibson/Wright
BK

Well Classification IIIA IIIB IIIC IV
* Well Data *

General Information
Drilling Method *Hand Rotary*
Depth to Bedrock _____
Static Water Level *45'*
Well Disinfected (Y or N) _____

Date Completed *5/21/02*
Yield *20* (GPM)
Stabilized Water Level *170*
Disinfectant Used _____

Total Depth of Well *230'*
Length of Test *approx 1 Hr.*
Natural Flow (Rate) _____
Amount Used _____

Casing
From *+1* To *200*
Size *4 1/2"* Material *PVC*
Weight/Schedule *SDR 17*

From *220* To *230*
Size *4 1/2"* Material *PVC*
Weight/Schedule *SDR 17*

From _____ To _____
Size _____ Material _____
Weight/Schedule _____

Gravel Pack
From *80* To *230*
Grout size
1/4" from *0* to *230ft.*
Grout
From *0* To *80+*
Bore Hole Size *7 1/8* *5/24/02*
Type *Grout*
Method *Pressure Grouting*

From _____ To _____
" from _____ to _____ ft.
From _____ To _____
Bore Hole Size _____
Type _____
Method _____

From _____ To _____
" from _____ to _____ ft.
From _____ To _____
Bore Hole Size _____
Type _____
Method _____

Water Zones or Screened Intervals
From *200* To *220*
Mesh Size *0.20* Diam *4 1/2" (PVC)*

From _____ To _____
Mesh Size _____ Diam _____

From _____ To _____
Mesh Size _____ Diam _____

* Use Data *

Private Well: Domestic Agricultural _____ Industrial _____ Monitoring _____
Public Well: Community _____ Non Community _____

* Abandonment Information *


Bored or Dug Wells
Casing Removed, Y or N?: _____
If Y, Depth to which casing was removed: _____
Depth and Type of Fill: _____
Source of Fill _____
Bentonite Plugs: From _____ to _____ From _____ to _____

Wells other than Bored Wells
Casing removed, Y or N? _____
Depth to which casing was removed: _____
Applicable, depth(s), and type of gravel/sand fill: _____
Source of gravel or sand: _____
Cement: From _____ to _____ From _____ to _____

Method of permanently marking location:
 Installed watertight top
Suggest setting pump @ approx. *190* ft.

Design Co.
Jeanpaul. Libon
1000 Woods # 6
Blufford • Drillers Log
How can come off #624 - Morton Rd
 Description of Formation or Sediment

0	10	Brown clay
10	30	Gray clay
30	50	Gray sand & Gravel
50	70	Gray clay
70	130	Gray sand & Gravel
130	190	Gray & Brown clay
190	200	Gray sandy clay
200	220	Gray sand - water zone
220	230	Gray clay

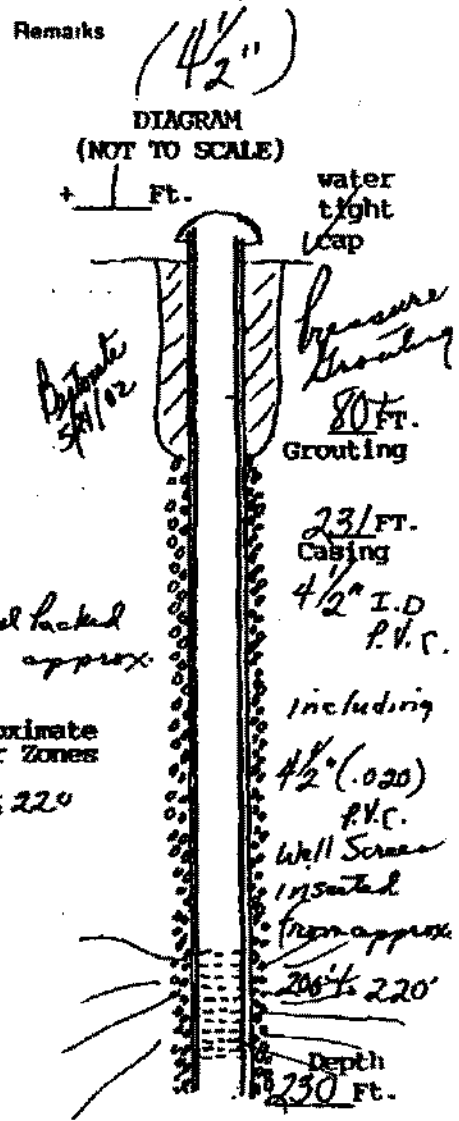

(Use additional Sheets if necessary)

I certify that the information contained here is true and that this well was installed and constructed in accordance with the permit and further that the well complies with all applicable state and local regulations, ordinances and laws.

Name JOHN L. DANIELSON, JR., INC.
 Address 4616 HOOD DRIVE
FREDERICKSBURG, VIRGINIA 22408
 Phone 540 (703) 898-6025 / 898-9355

Drillers Signature *John L. Danielson, Jr.*
 Date 5/20/02 Representing JOHN L. DANIELSON, JR., INC.

Virginia Contractors License Number CLASS A 2701 014084A II/II NVC