

Bryant
Box 3965
Fredricksburg, Va 22402
786-2100
898-2290

Commonwealth of Virginia

Uniform Water Well Completion Report

46-67

Owner Cashbach
Address _____
Phone _____
Location #676 off #1 (Crown Corner)

Tax Map ID 46-1-67
VDH Permit SWP-97-145
VWCB Permit _____
VWCB ID _____
County Stafford

Well Classification IIIA _____ IIIB IIIC _____ IV _____
* Well Data *

5/13/97 Mike Snyder
SFF

General Information

Drilling Method Rotary
Depth to Bedrock _____
Static Water Level 40'
Well Disinfected (Y or N) _____

Date Completed 11/17/97
Yield 30 (GPM)
Stabilized Water Level 100'
Disinfectant Used _____

Total Depth of Well 160
Length of Test approx 1 Hr.
Natural Flow (Rate) _____
Amount Used _____

Casing

From 1 To 85
Size 6 1/4 Material P.V.C.
Weight/Schedule S.D.R. 27

From 80 To 140
Size 4" Material P.V.C.
Weight/Schedule Sch. 40

From _____ To _____
Size _____ Material _____
Weight/Schedule _____

Gravel Pack

From _____ To _____

From _____ To _____

From _____ To _____

Hole size 10" from 0 to 50 ft.

7 7/8" from 50 to 85 ft.

6 1/2" from 85 to 160 ft.

Grout From 0 To 50'
Bore Hole Size 10"
Type Bentonite
Method Pressure Grouting

From _____ To _____
Bore Hole Size _____
Type _____
Method _____

From _____ To _____
Bore Hole Size _____
Type _____
Method _____

Water Zones or Screened Intervals

From 140 To 160
Mesh Size 20 Diam 4" (P.V.C.)
From _____ To _____
Mesh Size _____ Diam _____

approx water zone
From 140 To 160
Mesh Size _____ Diam _____
From _____ To _____
Mesh Size _____ Diam _____

From _____ To _____
Mesh Size _____ Diam _____
From _____ To _____
Mesh Size _____ Diam _____

* Use Data *

Private Well: Domestic Agricultural _____ Industrial _____ Monitoring _____
Public Well: Community _____ Non Community _____

* Abandonment Information *

Bored or Dug Wells

Casing Removed, Y or N? _____
If Y, Depth to which casing was removed: _____
Depth and Type of Fill: _____
Source of Fill _____
Bentonite Plugs: From _____ to _____ From _____ to _____

Wells other than Bored Wells

Casing removed, Y or N? _____
Depth to which casing was removed: _____
Applicable, depth(s), and type of gravel/sand fill: _____
Source of gravel or sand: _____
Cement: From _____ to _____ From _____ to _____

Method of permanently marking location:

Installed watertight top
Suggest setting pump @ approx 120 ft.

You will encounter 4" casing @ approx. 80 Ft.
Suggest keeping centralizers & torque wrenches out of 4" casing.


George J. Bryant
 Escalade # 676 off #1
 Stafford
 Cranocover

18 BOX 10-1
 150 COLDER GREEN
 11/18/97

• Drillers Log •

Depth	Description of Formation or Sediment	Remarks
0	10	Red Clay
10	30	Yellow Sand
30	40	Grey Sand
40	85	Blue Clay
85	140	Red Clay
140	160	Sand & Gravel - water zone

DIAGRAM (NOT TO SCALE)

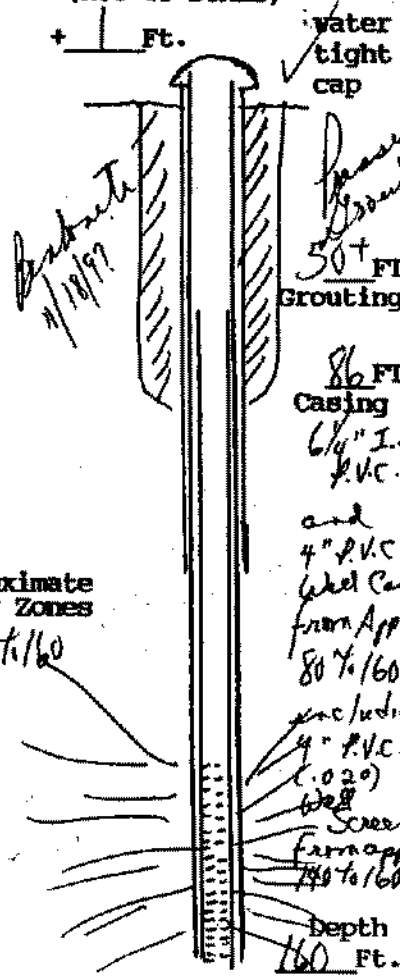

(User additional Sheets if necessary)

I certify that the information contained here is true and that this well was installed and constructed in accordance with the permit and further that the well complies with all applicable state and local regulations, ordinances and laws.

Name JOHN L. DANIELSON, JR., INC.
 Address 4616 HOOD DRIVE
FREDERICKSBURG, VIRGINIA 22408
 Phone 540 (703) 898-6025 / 898-9355
 Drillers Signature [Signature]
 Date 11/18/97 Representing JOHN L. DANIELSON, JR., INC.
 Virginia Contractors License Number CLASS A 2701 014084A H/H WVC