

Owner Virginia Housing Corp. Tax Map ID 46-28-6
Address P. O. Box 1657 VDH Permit SWP-97-426
Spotsylvania, VA 22553 VWCB Permit _____
Phone (540) 752-5929 VWCB ID _____
Location Bexley Manor Subd., Lot 6 County Stafford
Well Classification IIIA ~~IIIB XXXXXX~~ IIIC IV _____

* Well Data *

General Information:

Drilling Method Rotary Date Completed 04/07/98 Total Depth of Well 310 ft.
Depth to Bedrock _____ Yield 20 (GPM) Length of Test 4 hrs.
Static Water Level 120 Stblzd Water Level 150 Natural Flow (rate) _____
Well Chlr. (Y/N) Y Disinfectant Used chlorine Amount Used 50 PPM

Casing:

From +1 to 295 From 295 to 300 From _____ to _____
Size 4 1/2" Matl. PVC Size 2" Matl. Galv. Size _____ Matl. _____
~~XXXXXX~~ Sched. 40 ~~XXXXXX~~/Sched. 40 Weight/Sched. _____

Gravel Pack:

From _____ to _____ From _____ to _____ From _____ to _____

Grout:

From 0 to 50 From 50 to 295 From 295 to 310
Bore hole size 8" Bore hole size 7" Bore hole size 3-7/8"
Type Benseal Type _____ Type _____
Method Pressure Method _____ Method _____

Water Zones or Screened Intervals:

From 300 to 310 From _____ to _____ From _____ to _____
Mesh size 15 Diam. 2" Mesh size _____ Diam. _____ Mesh size _____ Diam. _____
From _____ to _____ From _____ to _____ From _____ to _____
Mesh size _____ Diam. _____ Mesh size _____ Diam. _____ Mesh size _____ Diam. _____

* Use Data *

Private Well: Domestic XXXXX Agricultural _____ Industrial _____ Monitoring _____
Public Well: Community _____ Non Community _____

* Abandonment Information *

Bored or Dug Wells:


Casing Removed, Y/N _____ Casing Removed, Y/N _____
If Y, Depth Removed _____ If Y, Depth Removed _____
Depth and Type of Fill _____ Depth and Type of Fill _____
Source of Fill _____ Source of Gravel or Sand _____
Bentonite Plugs: From _____ to _____ Cement: From _____ to _____
From _____ to _____ From _____ to _____

Method of permanently marking location: _____

VINCE

* DRILLERS LOG *

DEPTH	DESCRIPTION OF FORMATION OR SEDIMENT
0- 35	Sand
35-280	Blue sand
280-290	Brown clay
290-295	Pasty sand
295-310	Blue sand

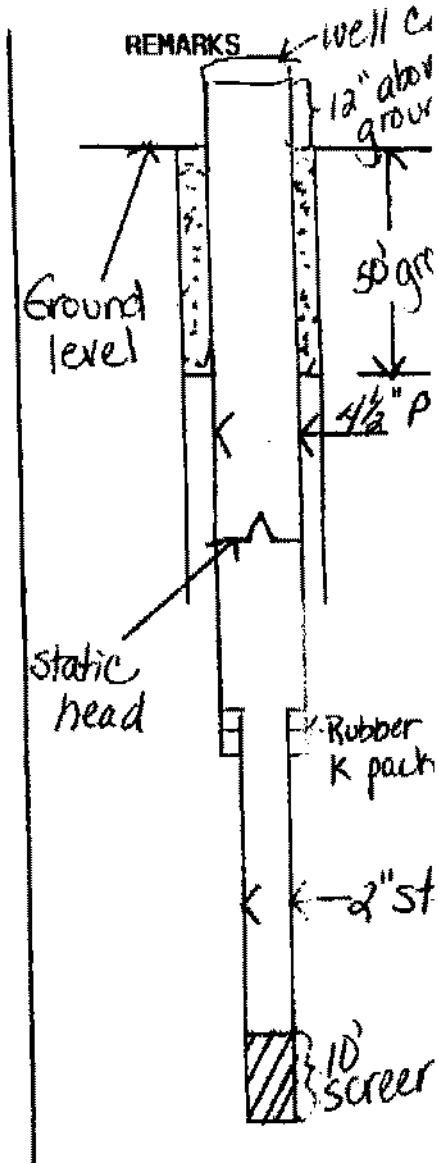

I certify that the information contained here is true and that this well was installed and constructed in accordance with the permit and further that the well complies with all applicable state and local regulations, ordinances and laws.

Name King George Drilling

Address Rt. 1 - Box 86K1

Colonial Beach, VA 22445

(804) 224-9130

Phone _____

Driller's Signature J. Anne Jordan - Shepherd

Date 04/07/98 representing Kenneth M. Frank, Jr. (Driller)

Virginia Contractors License Number 2701 023065A