

46-86-2-2

Owner Combered, Inc / For Sale (Barqan)
 Address 402 Old Landing Rd.
Richmond, VA 22405
 Phone 877-9889
 Location North Potomac #2
218 - 218 - Bacon Rd -> Lealand Rd -> Walnut Drive
 Well Classification IIIA IIIB IIIC IV

Tax Map ID 46-86-2-2
 VDH Permit 501P-98-405
 VWCB Permit _____
 VWCB ID _____
 County Stafford

* Well Data *

05C

General Information

Drilling Method Hand Rotary
 Depth to Bedrock _____
 Static Water Level _____
 Well Disinfected (Y or N) _____

Date Completed 4/16/99
 Yield 30 (GPM)
 Stabilized Water Level 180'
 Disinfectant Used _____

Total Depth of Well 268
 Length of Test approx 2 hrs
 Natural Flow (Rate) _____
 Amount Used _____

Casing

From 46 To 238
 Size 4 1/2" Material PVC
 Weight/Schedule SDR17

From 258 To 268
 Size 4 1/2" Material PVC
 Weight/Schedule SDR17

From _____ To _____
 Size _____ Material _____
 Weight/Schedule _____

Gravel Pack

From 50 To 268

From _____ To _____

From _____ To _____

Hole size

7 1/8" from 0 to 268 ft.

" from _____ to _____ ft.

" from _____ to _____ ft.

Grout

From 0 To 50'

From _____ To _____

From _____ To _____

Bore Hole Size

7 1/8" 4/16/99

Bore Hole Size

Bore Hole Size

Type

Bestonite

Type

Type

Method

Pressure Grouting

Method

Method

Water Zones or Screened Intervals

From 238 To 258
 Mesh Size 20 Diam 4 1/2" (PVC)
 From _____ To _____
 Mesh Size _____ Diam _____

approx water zone
 From 238 To 258
 Mesh Size _____ Diam _____
 From _____ To _____
 Mesh Size _____ Diam _____

From _____ To _____
 Mesh Size _____ Diam _____
 From _____ To _____
 Mesh Size _____ Diam _____

* Use Data *

Private Well: Domestic Agricultural _____ Industrial _____ Monitoring _____
 Public Well: Community _____ Non Community _____

* Abandonment Information *

Bored or Dug Wells

Casing Removed, Y or N? _____
 If Y, Depth to which casing was removed: _____
 Depth and Type of Fill: _____
 Source of Fill _____
 Bentonite Plugs: From _____ to _____ From _____ to _____

Wells other than Bored Wells

Casing removed, Y or N? _____
 Depth to which casing was removed: _____
 Applicable, depth(s), and type of gravel/sand fill: _____
 Source of gravel or sand: _____
 Cement: From _____ to _____ From _____ to _____

Method of permanently marking location: _____
 Installed watertight top
 Suggest setting pump @ approx. 200 ft.

Combined Inc /
 Carlson Drilling Services
 Norfolk, Virginia
 Morris Colman #2
 Stafford
 218 → Deacons → Lee Road → Walnut →

Drillers Log


Depth Description of Formation or Sediment Remarks

(42)

0	10	Red Clay
10	80	Sand & Gravel
80	100	Grey Clay
100	120	Sandy Grey Clay
120	200	Brown Clay
200	238	Sandy Grey Clay
238	258	Grey sand - water zone
258	268	Grey clay

DIAGRAM (NOT TO SCALE)

1 Ft.

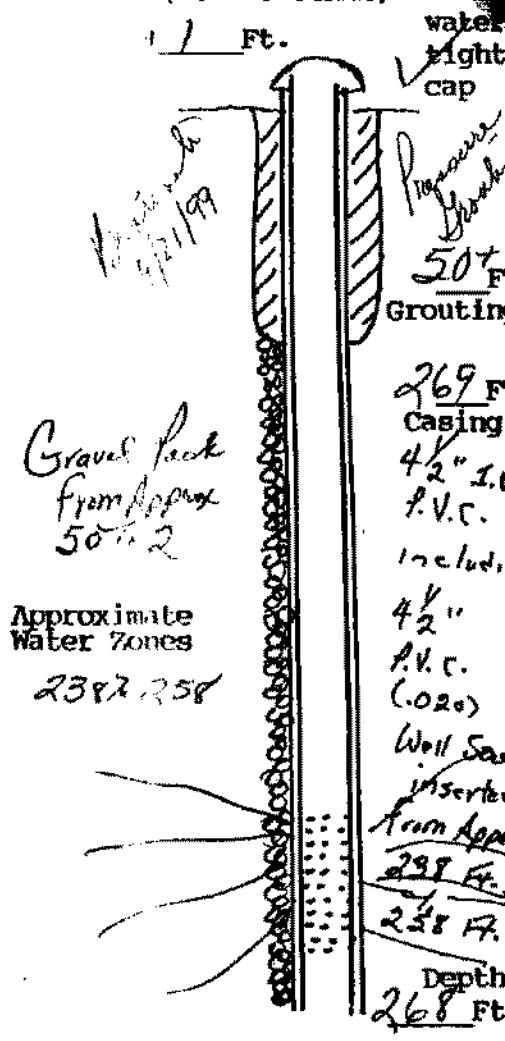

(User additional Sheets if necessary)

I certify that the information contained here is true and that this well was installed and constructed in accordance with the permit and further that the well complies with all applicable state and local regulations, ordinances and laws.

Name JOHN L. DANIELSON, JR., INC.
 Address 4616 HOOD DRIVE
FREDERICKSBURG, VIRGINIA 22408
 Phone (703) 898-6025 / 898-9355

Drillers Signature [Signature]
 Date 4/21/99 Representing JOHN L. DANIELSON, JR., INC.

Virginia Contractors License Number CLASS A 2701 014084A II/II WVC