

**Commonwealth of Virginia
Uniform Water Well Completion Report**

Owner Donald Greenwalt
 Address 1500 Forbes St
Fredericksburg Va 22405
 Phone 373-2141
 Location _____

Tax Map ID 46-20A
 VDH Permit WP-98-169
 VWCB Permit _____
 VWCB ID _____
 County STAFFORD
Ashton Wright 4/20/98
C.G.

Well Classification IIIA _____ IIIB IIIC _____ IV _____
 * Well Data *

General Information

Drilling Method Mud Rotary
 Depth to Bedrock _____
 Static Water Level 40
 Well Disinfected (Y or N) Y

Date Completed 5-5-98
 Yield 25 (GPM)
 Stabilized Water Level _____
 Disinfectant Used HTH

Total Depth of Well 115'
 Length of Test 1 hr.
 Natural Flow (Rate) _____
 Amount Used 11b

Casing

From +1 To 85
 Size 4 1/2" Material PVC
 Weight/Schedule SDR 17

From 105' To 115'
 Size 4 1/2" Material PVC
 Weight/Schedule SDR 17

From _____ To _____
 Size _____ Material _____
 Weight/Schedule _____

Gravel Pack

From 50' To 115'

From _____ To _____

From _____ To _____

Hole size

7 1/8" From 0 to 115 ft.

_____ " from _____ to _____ ft.

_____ " from _____ to _____ ft.

Grout

From 0 To 50

From _____ To _____

From _____ To _____

Bore Hole Size 8"

Bore Hole Size _____

Bore Hole Size _____

Type Bentonite

Type _____

Type _____

Method Pressure

Method _____

Method _____

Water Zones or Screened Intervals

From 85 To 105

From _____ To _____

From _____ To _____

Mesh Size .020 Diam 4 1/2"

Mesh Size _____ Diam _____

Mesh Size _____ Diam _____

From _____ To _____

From _____ To _____

From _____ To _____

Mesh Size _____ Diam _____

Mesh Size _____ Diam _____

Mesh Size _____ Diam _____

*** Use Data ***

Private Well: Domestic Agricultural _____ Industrial _____ Monitoring _____
 Public Well: Community _____ Non Community _____

*** Abandonment Information ***

Bored or Dug Wells

Casing Removed, Y or N? _____
 If Y, Depth to which casing was removed: _____
 Depth and Type of Fill: _____
 Source of Fill _____
 Bentonite Plugs: From _____ to _____ From _____ to _____

Wells other than Bored Wells

Casing removed, Y or N? _____
 Depth to which casing was removed: _____
 Applicable, depth(s), and type of gravel/sand fill: _____
 Source of gravel or sand: _____
 Cement: From _____ to _____ From _____ to _____

Method of permanently marking location: _____


Installed watertight top
 Suggest setting pump @ approx. 80 ft.

Donald Greenwalt
1500 Forbes St.

* Drillers Log *

Depth Description of Formation or Sediment Remarks

0	10	Sandy Red Clay
10	50	Yellow Sand
50	60	Black Sand
60	70	Sandy Grey clay
70	105	Sand + Gravel
105	115	Grey Clay

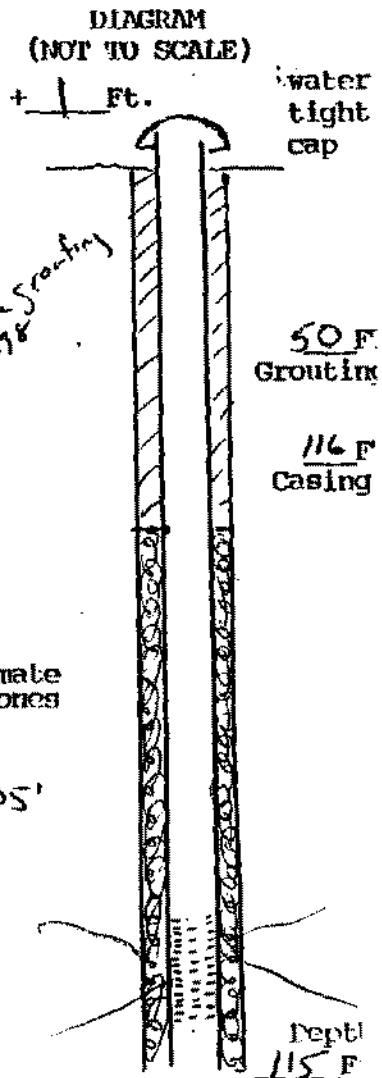

Approximate Water Zones

85' to 105'

(Use additional Sheets if necessary)

I certify that the information contained here is true and that this well was installed and constructed in accordance with the permit and further that the well complies with all applicable state and local regulations, ordinances and laws.

Name JOHN L. DANIELSON, JR., INC.
 Address 4616 HOOD DRIVE
FREDERICKSBURG, VIRGINIA 22408
 Phone 540 (308) 898-6025 / 898-9355

Drillers Signature *John L. Danielson, Jr.*
 Date 5-6-58 Representing JOHN L. DANIELSON, JR., INC.

Virginia Contractors License Number CLASS A 2701 014084A H/H WVC