

ing to 22404  
786-9547

Commonwealth of Virginia  
Uniform Water Well Completion Report

Owner Rodney Justice  
Address 10 Bellwood Road  
Salmonville, Va. 22405  
Phone 373-1449  
Location 1456 Jones St. (Lot #1)

Tax Map ID \_\_\_\_\_  
VDH Permit WS-91-195/W-93-29  
VWCB Permit 46-21B-1  
VWCB ID \_\_\_\_\_  
County Stafford  
2/19/93 Robert Snyder 1/27/93 Ashton Wright  
J.J. Harrison 1/29/93 T.T. Thompson

Well Classification IIIA \_\_\_\_\_ IIIB  IIIC \_\_\_\_\_ IV \_\_\_\_\_  
\* Well Data \*

General Information  
Drilling Method Air Rotary  
Depth to Bedrock \_\_\_\_\_  
Static Water Level 40  
Well Disinfected (Y or N) \_\_\_\_\_

Date Completed 2/5/93  
Yield 30 (GPM)  
Stabilized Water Level 80  
Disinfectant Used \_\_\_\_\_

Total Depth of Well 140  
Length of Test 4 HRS.  
Natural Flow (Rate) \_\_\_\_\_  
Amount Used \_\_\_\_\_

Casing  
From +1 To 72  
Size 6 3/4 Material P.V.C.  
Weight/Schedule SDR 27

From 72 To 112  
Size 6 3/4 Material P.V.C.  
Weight/Schedule SDR 21

From 100 To 120  
Size 4 Material P.V.C.  
Weight/Schedule Sch. 40

Gravel Pack  
From \_\_\_\_\_ To \_\_\_\_\_

From \_\_\_\_\_ To \_\_\_\_\_

From \_\_\_\_\_ To \_\_\_\_\_

Hole size  
10" from 0 to 110 ft.  
Grout  
From 0 To 70+  
Bore Hole Size 10"  
Type Bentonite  
Method Pressure Grouting

6" from 110 to 140 ft.  
From \_\_\_\_\_ To \_\_\_\_\_  
Bore Hole Size \_\_\_\_\_  
Type \_\_\_\_\_  
Method \_\_\_\_\_

" from \_\_\_\_\_ to \_\_\_\_\_ ft.  
From \_\_\_\_\_ To \_\_\_\_\_  
Bore Hole Size \_\_\_\_\_  
Type \_\_\_\_\_  
Method \_\_\_\_\_

Water Zones or Screened Intervals  
From 120 To 140  
Mesh Size 20 Diam 4" P.V.C.  
From \_\_\_\_\_ To \_\_\_\_\_  
Mesh Size \_\_\_\_\_ Diam \_\_\_\_\_

Approx. water zone  
From 115 To 140  
Mesh Size \_\_\_\_\_ Diam \_\_\_\_\_  
From \_\_\_\_\_ To \_\_\_\_\_  
Mesh Size \_\_\_\_\_ Diam \_\_\_\_\_

From \_\_\_\_\_ To \_\_\_\_\_  
Mesh Size \_\_\_\_\_ Diam \_\_\_\_\_  
From \_\_\_\_\_ To \_\_\_\_\_  
Mesh Size \_\_\_\_\_ Diam \_\_\_\_\_

\* Use Data \*

Private Well: Domestic  Agricultural \_\_\_\_\_ Industrial \_\_\_\_\_ Monitoring \_\_\_\_\_  
Public Well: Community \_\_\_\_\_ Non Community \_\_\_\_\_

\* Abandonment Information \*

Bored or Dug Wells  
Casing Removed, Y or N?: \_\_\_\_\_  
If Y, Depth to which casing was removed: \_\_\_\_\_  
Depth and Type of Fill: \_\_\_\_\_  
Source of Fill \_\_\_\_\_  
Bentonite Plugs: From \_\_\_\_\_ to \_\_\_\_\_ From \_\_\_\_\_ to \_\_\_\_\_

Wells other than Bored Wells  
Casing removed, Y or N? \_\_\_\_\_  
Depth to which casing was removed: \_\_\_\_\_  
Applicable, depth(s), and type of gravel/sand fill: \_\_\_\_\_  
Source of gravel or sand: \_\_\_\_\_  
Cement: From \_\_\_\_\_ to \_\_\_\_\_ From \_\_\_\_\_ to \_\_\_\_\_


Method of permanently marking location: \_\_\_\_\_  
 Installed watertight top  
Suggest setting pump @ approx. 100 ft.  
Casing telescopes to 4" @ approx 100 ft.  
Well pumped 15 G.P.M @ 100' on 2/5/93

St. / 627  
 156 Forbes St. 41 -

• Drillers Log •

Depth	Description of Formation or Sediment	Remarks
0	10	Red Clay
10	40	Sandy Red Clay
40	80	Black Sand & Shells
80	100	Grey Sandy Clay
100	115	Grey Clay
115	140	Grey Sandstone

DIAGRAM  
 (NOT TO SCALE)

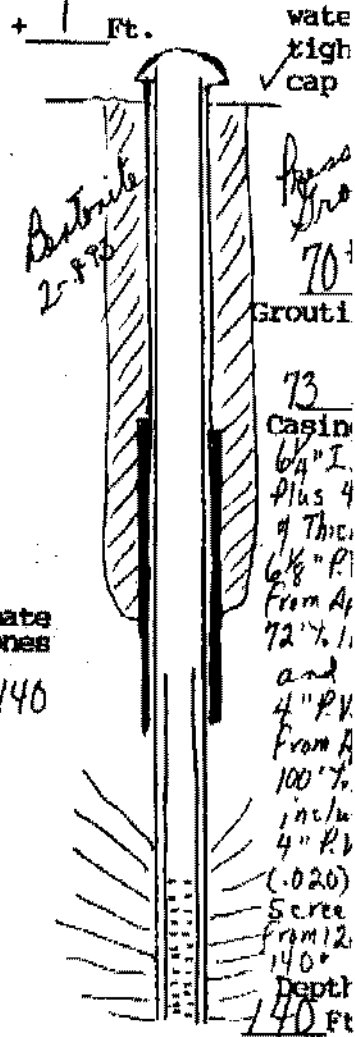

Approximate  
 Water Zones  
 115' to 140'

(User additional Sheets if necessary)

I certify that the information contained here is true and that this well was installed and constructed in accordance with the permit and further that the well complies with all applicable state and local regulations, ordinances and laws.

Name JOHN L. DANIELSON, JR., INC.

Address 4616 HOOD DRIVE  
FREDERICKSBURG, VIRGINIA 22408

Phone (703) 898-6025 / 898-9355

Drillers Signature *John L. Danielson, Jr.*

Date 2/8/93 Representing JOHN L. DANIELSON, JR., INC.

Virginia Contractors License Number \_\_\_\_\_