

Commonwealth of Virginia Uniform Water Well Completion Report

Owner Raymond C. & Tracy K. Hensley
 Address 156 Cranberry Pkwy Rd
Salisbury, Va. 22405
 Phone _____
 Location Kelly Family #4 1 1/2 M. on Cranberry Rd.
 Well Classification IIIA IIIB IIIC IV
 * Well Data *

Tax Map ID 46-69-D
 VDH Permit 415-92-230
 VWCB Permit _____
 VWCB ID _____
 County Stafford
12/1/92 Daniel Gesselyn
12/7/92 J.J. Thompson 9/13/93

General Information

Drilling Method Air Rotary Date Completed 9/27/93 Total Depth of Well 180
 Depth to Bedrock _____ Yield 20 (GPM) Length of Test 1 Hr -
 Static Water Level 30 Stabilized Water Level _____ Natural Flow (Rate) _____
 Well Disinfected (Y or N) _____ Disinfectant Used _____ Amount Used _____

Casing

From <u>+1</u> To <u>104</u>	From <u>95</u> To <u>160</u>	From _____ To _____
Size <u>6 1/4</u> Material <u>Steel</u>	Size <u>4</u> Material <u>P.V.C.</u>	Size _____ Material _____
Weight/Schedule <u>188/13 lb per ft</u>	Weight/Schedule <u>Sch. 40</u>	Weight/Schedule _____

Gravel Pack

From _____ To _____	From _____ To _____	From _____ To _____
Hole size <u>10" from 0 to 65ft.</u>	<u>7 7/8" from 65 to 103ft.</u>	<u>6" from 103 to 180ft.</u>
Grout From <u>0</u> To <u>65+</u>	From _____ To _____	From _____ To _____
Bore Hole Size <u>16" 9/23/93</u>	Bore Hole Size _____	Bore Hole Size _____
Type <u>Densitec</u>	Type _____	Type _____
Method <u>Pressure Grouting</u>	Method _____	Method _____

Water Zones or Screened Intervals

From <u>160</u> To <u>180</u>	From <u>165</u> To <u>175</u>	From _____ To _____
Mesh Size <u>.020</u> Diam <u>4" P.V.C.</u>	Mesh Size _____ Diam _____	Mesh Size _____ Diam _____
From _____ To _____	From _____ To _____	From _____ To _____
Mesh Size _____ Diam _____	Mesh Size _____ Diam _____	Mesh Size _____ Diam _____

* Use Data *

Private Well: Domestic Agricultural _____ Industrial _____ Monitoring _____
 Public Well: Community _____ Non Community _____


* Abandonment Information *

Bored or Dug Wells	Wells other than Bored Wells
Casing Removed, Y or N? _____	Casing removed, Y or N? _____
If Y, Depth to which casing was removed: _____	Depth to which casing was removed: _____
Depth and Type of Fill: _____	Applicable, depth(s), and type of gravel/sand fill: _____
Source of Fill _____	Source of gravel or sand: _____
Remediate Plugs: From _____ to _____ From _____ to _____	Cement: From _____ to _____ From _____ to _____

Method of permanently marking location: Installed watertight top
 Suggest setting pump @ approx 120 ft.
You will encounter 4" P.V.C. casing @ approx. 95 ft
I know in this area there are 4" casing

Blasney
#4
Hord #676
9710 M. on Crane's Corner Rd. / on Right
Drillers Log

Depth	Description of Formation or Sediment	Remarks
0	10	Red Clay
0	40	Clay & Gravel
40	60	Blue clay
60	100	Sand & Gravel
100	165	Brown Clay
165	175	Grey Sand - water zone
175	180	Blue clay

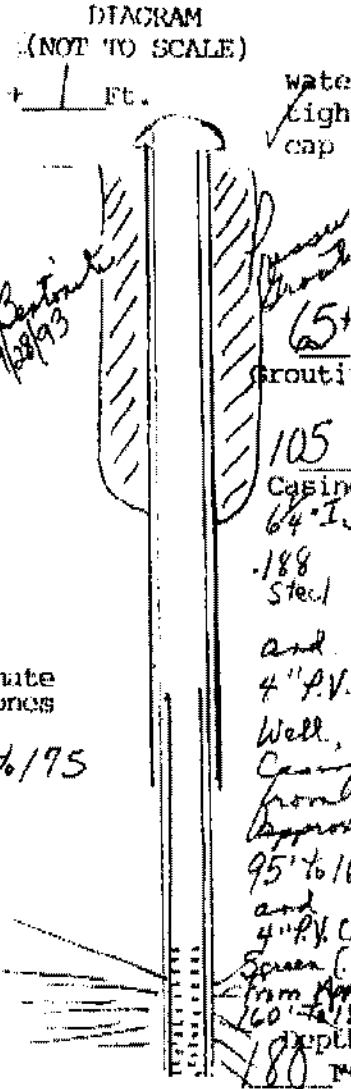

Approximate Water Zones
165/175

(User additional Sheets if necessary)

I certify that the information contained here is true and that this well was installed and constructed in accordance with the permit and that the well complies with all applicable state and local regulations, ordinances and laws.

Name: JOHN L. DANIELSON, JR., INC.
 Address: 4616 HOOD DRIVE
FREDERICKSBURG, VIRGINIA 22408
 Phone: (703) 898-6025 / 898-9355

Signature: [Signature]
 Date: 9/28/93 Representing: JOHN L. DANIELSON, JR., INC.

Contractors License Number: CLASS A 2701 014084A 11/11 WVC