

Commonwealth of Virginia
Uniform Water Well Completion Report

752-7555
 Owner Cathy & Steve Harrison *Account issued to*
 Address 223 Betty Lewis Drive Eastern Va. Land Co.
Fredericksburg, Va 22405 P.O. Box 42163
Fredericksburg, Va 22404 Ft.burg, 22404
 Phone 373-3929 371-8218
 Location # 628 → 608 → 2 Miles Across Blomac Creek/Top of Hill
 Well Classification IIIA _____ IIIB IIIC _____ IV _____
 * Well Data *
 Tax Map ID 47-59
 VDH Permit SW-94-162
 VWCB Permit _____
 VWCB ID _____
 County STAFFORD
5/10/94 Robert B. Wright
5/2/94 J.J. Thompson

General Information
 Drilling Method Air Rotary Date Completed 8/30/94 Total Depth of Well 190'
 Depth to Bedrock _____ Yield 30 (GPM) Length of Test approx 3 Hrs
 Static Water Level _____ Stabilized Water 100' Natural Flow (Rate) _____
 Well Disinfected (Y or N) _____ Disinfectant Used _____ Amount Used _____

Casing
 From +1 To 110 From 110 To 170 From 160 To 170
 Size 6 1/4 Material P.V.C. Size 6 1/8 Material P.V.C. Size 4" Material P.V.C.
 Weight/Schedule SDR 27 Weight/Schedule SDR 21 Weight/Schedule ScL 40

Gravel Pack
 From _____ To _____ From _____ To _____ From _____ To _____
Hole size
10" From 0 to 50 Ft. 7 1/8" From 50 to 170 Ft. " From _____ to _____ Ft.
Grout
 From 0 To 50' From _____ To _____ From _____ To _____
 Bore Hole Size 10" 9/1/94 Bore Hole Size _____ Bore Hole Size _____
 Type Bentonite Type _____ Type _____
 Method Pressure Grouting Method _____ Method _____

Water Zones or Screened Intervals
 From 170 To 190 From 172 To 185 From _____ To _____
 Mesh Size 0.20 Diam 4" (P.V.C.) Mesh Size _____ Diam _____ Mesh Size _____ Diam _____
 From _____ To _____ From _____ To _____ From _____ To _____
 Mesh Size _____ Diam _____ Mesh Size _____ Diam _____ Mesh Size _____ Diam _____

* Use Data *

Private Well: Domestic Agricultural _____ Industrial _____ Monitoring _____
 Public Well: Community _____ Non Community _____

* Abandonment Information *

Bored or Dug Wells
 Casing Removed, Y or N? _____
 If Y, Depth to which casing was removed: _____
 Depth and Type of Fill: _____
 Source of Fill _____
 Bentonite Plugs: From _____ to _____ From _____ to _____

Wells other than Bored Wells
 Casing removed, Y or N? _____
 Depth to which casing was removed: _____
 Applicable, depth(s), and type of gravel/sand fill: _____
 Source of gravel or sand: _____
 Cement: From _____ to _____ From _____ to _____



Method of permanently marking location: _____
 Installed watertight top
 Suggest setting pump @ approx. 120 Ft. (Pumped 15 G.P.M. @ 120' on 8/30/94)
Casing telescopes to 4" @ approx 160 Feet.

Permit
 Virginia
 Department of Health
 of Company/Corporation/Individual
 P.O. Box 243, Stafford,
 Eastern Virginia
 Address:

Doree Dezigas
Cathy & Steve Harrox
Stafford
 #608

628 → 3 Miles → Rox #608 → * Drillers Log
 Cross Potomac Creek - Top of H.

Depth	Description of Formation or Sediment	Remarks
0	10	yellow sandy clay
10	40	Brown clay
40	60	Black sand & shells
60	80	Grey clay
80	160	Black sand & shells
160	172	Sandy Grey Clay
172	185	Grey sand & Gravel (water zone)
185	190	Brown clay

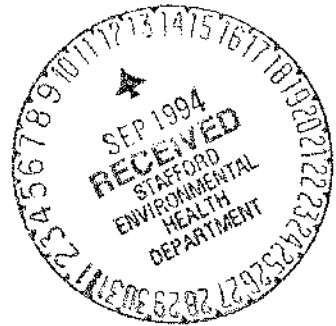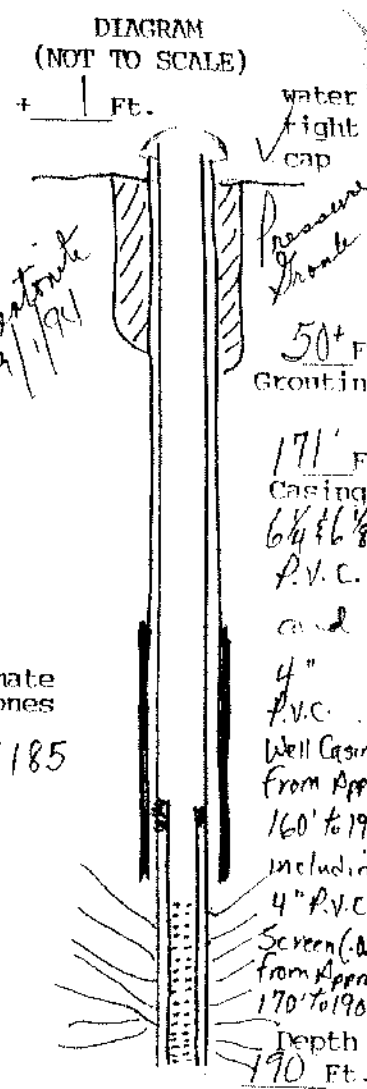

Approximate
 Water Zones
 172 & 185

(Use additional Sheets if necessary)

I certify that the information contained here is true and that this well was installed and constructed in accordance with the permit and further that the well complies with all applicable state and local regulations, ordinances and laws

Name JOHN L. DANIELSON, JR., INC.
 Address 4616 HOOD DRIVE
FREDERICKSBURG, VIRGINIA 22408
 Phone (703) 898-6025 / 898-9355

Drillers Signature John L. Danielson, Pres.
 Date 9/1/94 Representing JOHN L. DANIELSON, JR., INC.

Virginia Contractors License Number CLASS A 2701 014084A II/H WMC