

**Commonwealth of Virginia
Uniform Water Well Completion Report**

Owner Charles Fleetwood
 Address 55 Paul Hill Road
Fredricksburg Va. 22405
 Phone 899-1943 w. 373-08159 Fax 899-0668
 Location Fleetwood Subdivision #3 / October Rd. (Le land)
183c
 Well Classification IIIA IIIB IIIC IV
 (Approx 3/4 Miles East of Deacon Rd & LeLand Rd.) * Well Data *

Tax Map ID 47-8E-3
 VDH Permit SWP-95-97
 VWCB Permit _____
 VWCB ID _____
 County Stafford
4/5/95 Carlton Wright
SFF

General Information

Drilling Method Mud Rotary Date Completed 6/16/95 Total Depth of Well 200'
 Depth to Bedrock _____ Yield 15 (GPM) Length of Test approx 1 Hr.
 Static Water Level 7.5' Stabilized Water Level 140' Natural Flow (Rate) _____
 Well Disinfected (Y or N) _____ Disinfectant Used _____ Amount Used _____

Casing

| | | |
|--|--------------------------------|--------------------------------|
| From <u>+1</u> To <u>95</u> | From <u>90</u> To <u>170</u> | From <u>190</u> To <u>200</u> |
| Size <u>6 1/4" Material Steel</u> | Size <u>4" Material P.V.C.</u> | Size <u>4" Material P.V.C.</u> |
| Weight/Schedule <u>188/13.16 per ft.</u> | Weight/Schedule <u>Sch 40</u> | Weight/Schedule <u>Sch 40</u> |

Gravel Pack

From _____ To _____ From _____ To _____ From _____ To _____

Hole size

10" from 0 to 60 ft. 7 1/8" from 60 to 95 ft. 6" from 95 to 200 ft.

Grout

| | | |
|--|----------------------|----------------------|
| From <u>0</u> To <u>50'</u> <u>4/16/95</u> | From _____ To _____ | From _____ To _____ |
| Bore Hole Size <u>10"</u> | Bore Hole Size _____ | Bore Hole Size _____ |
| Type <u>Portland Cement</u> | Type _____ | Type _____ |
| Method <u>Pressure Grouting</u> | Method _____ | Method _____ |

Water Zones or Screened Intervals

| | | |
|---|---|----------------------------|
| From <u>170</u> To <u>190</u> | <u>approx water zone</u> From <u>172</u> To <u>185</u> | From _____ To _____ |
| Mesh Size <u>1020</u> Diam <u>4" (P.V.C.)</u> | Mesh Size _____ Diam _____ | Mesh Size _____ Diam _____ |
| From _____ To _____ | From _____ To _____ | From _____ To _____ |
| Mesh Size _____ Diam _____ | Mesh Size _____ Diam _____ | Mesh Size _____ Diam _____ |

*** Use Data ***

Private Well: Domestic Agricultural _____ Industrial _____ Monitoring _____
 Public Well: Community _____ Non Community _____

*** Abandonment Information ***

Bored or Dug Wells

Casing Removed, Y or N?: _____
 If Y, Depth to which casing was removed: _____
 Depth and Type of Fill: _____
 Source of Fill: _____
 Bentonite Plugs: From _____ to _____ From _____ to _____

Wells other than Bored Wells


Casing removed, Y or N? _____
 Depth to which casing was removed: _____
 Applicable, depth(s), and type of gravel/sand fill: _____
 Source of gravel or sand: _____
 Cement: From _____ to _____ From _____ to _____

Method of permanently marking location:

Installed watertight top
 Suggest setting pump @ approx. 160 ft.
Casing telescopes to 4" @ approx 90 ft.
Suggest keeping torque arrestors & centralizers out of 4" casing.

Charles Fleetwood
Octagon Lane
Stafford
off Season 4 Leland Road
 Drillers Log

| Depth | Description of Formation or Sediment | Remarks |
|-------|--------------------------------------|------------------------|
| 0 | 10 | Sandy Red Clay |
| 10 | 40 | Sand & Gravel |
| 40 | 95 | Blue Marl |
| 95 | 110 | Sandstone |
| 110 | 172 | Blue Clay |
| 172 | 185 | Grey sand - water zone |
| 185 | 200 | Brown Clay |

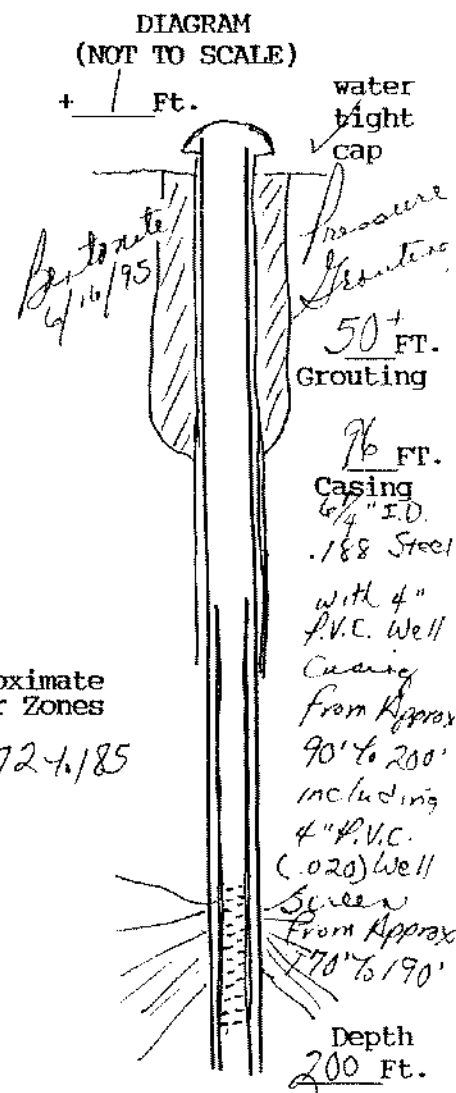

(User additional Sheets if necessary)

I certify that the information contained here is true and that this well was installed and constructed in accordance with the permit and further that the well complies with all applicable state and local regulations, ordinances and laws.

Name JOHN L. DANIELSON, JR., INC.
 Address 4616 HOOD DRIVE
FREDERICKSBURG, VIRGINIA 22408
 Phone (703) 898-6025 / 898-9355

Drillers Signature John L. Danielson, Jr.
 Date 6/19/95 Representing JOHN L. DANIELSON, JR., INC.

Virginia Contractors License Number CLASS A 2701 014084A H/H WWC