

Commonwealth of Virginia  
Uniform Water Well Completion Report

Owner <u>Brinda Parish</u>	Tax Map ID <u>SWP-98-85</u>
Address <u>P. O. Box 42169</u>	VMI Permit <u>47D-4</u>
<u>Fredericksburg, VA 22404</u>	VWCB Permit _____
Phone <u>(804) 742-5805</u>	VWCB ID _____
Location <u>Bexley Manor Subd., Lot 4</u>	County <u>Stafford</u>
Well Classification <u>IIIA</u>	<u>IIIB XXXXX</u>
	<u>IIIC</u>
	<u>IV</u>

\* Well Data \*

General Information

Drilling Method <u>Rotary</u>	Date Completed <u>07/21/98</u>	Total Depth Of Well <u>385 ft.</u>
Depth to Bedrock _____	Yield <u>12</u> (GPM)	Length of Test <u>4 hrs.</u>
Static Water Level <u>100</u>	Stblzd Water Level <u>130</u>	Natural Flow (rate) _____
Well Disinfected (Y/N) <u>Y</u>	Disinfectant Used <u>chlorine</u>	Amount Used <u>50 PPM</u>

Casing

From <u>+1</u> to <u>298</u>	From <u>298</u> to <u>350</u>	From <u>370</u> to <u>385</u>
Size <u>4 1/2"</u> Material <u>PVC</u>	Size <u>2"</u> Material <u>Galv.</u>	Size <u>2"</u> Material <u>Galv.</u>
<del>XXXXXX</del> / Schedule <u>40</u>	<del>XXXXXX</del> / Schedule <u>40</u>	<del>XXXXXX</del> / Schedule <u>40</u>

Gravel Pack

From _____ to _____	From _____ to _____	From _____ to _____
---------------------	---------------------	---------------------

Grout

From <u>0</u> to <u>50</u>	From <u>50</u> to <u>298</u>	From <u>298</u> to <u>385</u>
Bore Hole Size <u>8"</u>	Bore Hole Size <u>7"</u>	Bore Hole Size <u>3-7/8"</u>
Type <u>Beniseal</u>	Type _____	Type _____
Method <u>Pressure</u>	Method _____	Method _____

Water Zones or Screened Intervals

From <u>350</u> to <u>360</u>	From _____ to _____	From _____ to _____
Mesh Size <u>15</u> Diam. <u>2"</u>	Mesh Size _____ Diam. _____	Mesh Size _____ Diam. _____
From <u>360</u> to <u>370</u>	From _____ to _____	From _____ to _____
Mesh Size <u>10</u> Diam. <u>2"</u>	Mesh Size _____ Diam. _____	Mesh Size _____ Diam. _____

\* Use Data \*

Private Well: Domestic XXXXX Agricultural \_\_\_\_\_ Industrial \_\_\_\_\_ Monitoring \_\_\_\_\_  
Public Well: Community \_\_\_\_\_ Non Community \_\_\_\_\_

\* Abandonment Information \*

Bored or Dug Wells

Casing Removed, Y or N?: \_\_\_\_\_  
If Y, Depth Removed: \_\_\_\_\_  
Depth and Type of Fill: \_\_\_\_\_  
Source of Fill: \_\_\_\_\_  
Bentonite Plugs: From \_\_\_\_\_ to \_\_\_\_\_  
From \_\_\_\_\_ to \_\_\_\_\_

Wells other than Bored Wells


Casing Removed, Y or N?: \_\_\_\_\_  
If Y, Depth Removed: \_\_\_\_\_  
Depth and type of Fill: \_\_\_\_\_  
Source of Gravel or Sand: \_\_\_\_\_  
Cement: From \_\_\_\_\_ to \_\_\_\_\_  
From \_\_\_\_\_ to \_\_\_\_\_

Method of permanently marking location: \_\_\_\_\_

\*DRILLERS LOG\*

150 COLDE GREENWICH  
P.O. BOX 781

DEPTH	DESCRIPTION OF FORMATION OR SEDIMENT
0- 35	Sand
35-135	Blue sand
135-150	Sandstone
150-275	Blue sand (no water)
275-340	Green and brown clay
340-346	Blue sand
346-347	Pasty sand
347-360	Blue sand (water)
360-365	Sandstone
365-371	Blue sand (water)
371-385	Hard sand

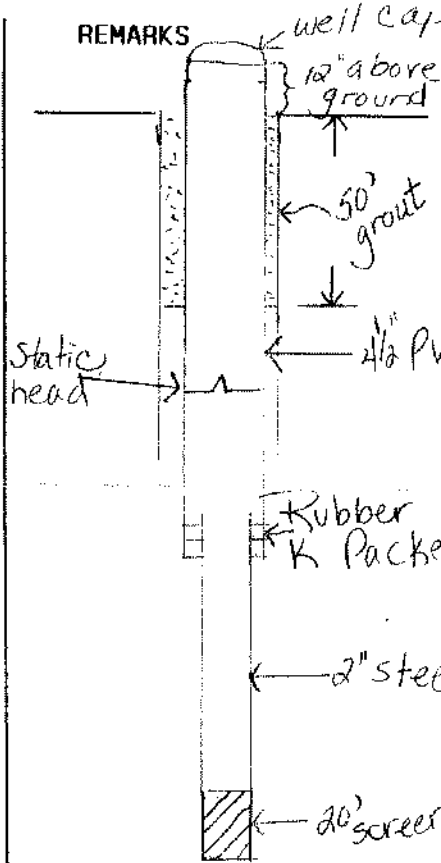

I certify that the information contained here is true and that this well was installed and constructed in accordance with the permit and further that the well complies with all applicable state and local regulations, ordinances and laws.

Name King George Drilling Service, Inc.  
 Address 861 Macedonia Lane  
Colonial Beach, VA 22443  
 Phone (804) 224-9130

Driller's Signature *Anne Jordan - Shepherd*  
 Date 7-21-98 Representing Kenneth M. Frank, Jr.

Virginia Contractors License Number 2701 023065A