

Commonwealth of Virginia
Uniform Water Well Completion Report

Name Michael A. Sielicki
 Address P.O. Box 1775
Stafford, VA 22555
 Phone 703-840-1916
 Location Rte. 600 to Rte. 712 (on left side)
 Well Classification IIIA _____ IIIB IIIC _____ IV _____

Tax Map ID 48-24B
 VDI Permit SWP-94-343
 VWCB Permit _____
 VWCB ID _____
 County Stafford

* Well Data *

General Information

Drilling Method Rotary Date Completed 4-12-95 Total Depth of Well 211 FT.
 Depth to Bedrock _____ Yield 15 (GPM) Length of Test 4 hrs.
 Static Water Level 90 Stblzd Water Level 130 Natural Flow (rate) _____
 Well Disinfected (Y/N) Disinfectant Used Chlorine Amount Used 50 PPM

Casing

From <u>+1</u> to <u>150</u>	From <u>150</u> to <u>201</u>	From _____ to _____
Size <u>4 1/2"</u> Material <u>PVC</u>	Size <u>2"</u> Material <u>galv.</u>	Size _____ Material _____
Weight/Schedule <u>40</u>	Weight/Schedule <u>40</u>	Weight/Schedule _____

Gravel Pack

From _____ to _____ From _____ to _____ From _____ to _____

Grout

From <u>0</u> to <u>50</u>	From <u>50</u> to <u>150</u>	From <u>150</u> to <u>211</u>
Bore Hole Size <u>8"</u>	Bore Hole Size <u>7"</u>	Bore Hole Size <u>3 7/8"</u>
Type <u>Benseal</u>	Type _____	Type _____
Method <u>Pressure</u>	Method _____	Method _____

Water Zones or Screened Intervals

From <u>201</u> to <u>211</u>	From _____ to _____	From _____ to _____
Mesh Size <u>15</u> Diam. <u>2"</u>	Mesh Size _____ Diam. _____	Mesh Size _____ Diam. _____
From _____ to _____	From _____ to _____	From _____ to _____
Mesh Size _____ Diam. _____	Mesh Size _____ Diam. _____	Mesh Size _____ Diam. _____

* Use Data *

Private Well: Domestic Agricultural _____ Industrial _____ Monitoring _____
 Public Well: Community _____ Non Community _____

* Abandonment Information *

Bored or Dug Wells

Casing Removed, Y or N?: _____
 If Y, Depth Removed: _____
 Depth and Type of Fill: _____
 Source of Fill: _____
 Bentonite Plugs: From _____ to _____
 From _____ to _____

Wells other than Bored Wells


Casing Removed, Y or N?: _____
 If Y, Depth Removed: _____
 Depth and type of Fill: _____
 Source of Gravel or Sand: _____
 Cement: From _____ to _____
 From _____ to _____

Method of permanently marking location: _____

Gilbert
 BERNICH DRILLING

DRILLERS LOG

DEPTH	DESCRIPTION OF FORMATION OR SEDIMENT
0 - 20	Sand & gravel
20 - 80	Green clay
80 - 140	Black sand & shells
140 - 150	Gray clay & pasty sand
150 - 155	Blue & white sand
155 - 165	Gray clay
165 - 180	Gray pasty clay
180 - 211	Blue & white sand

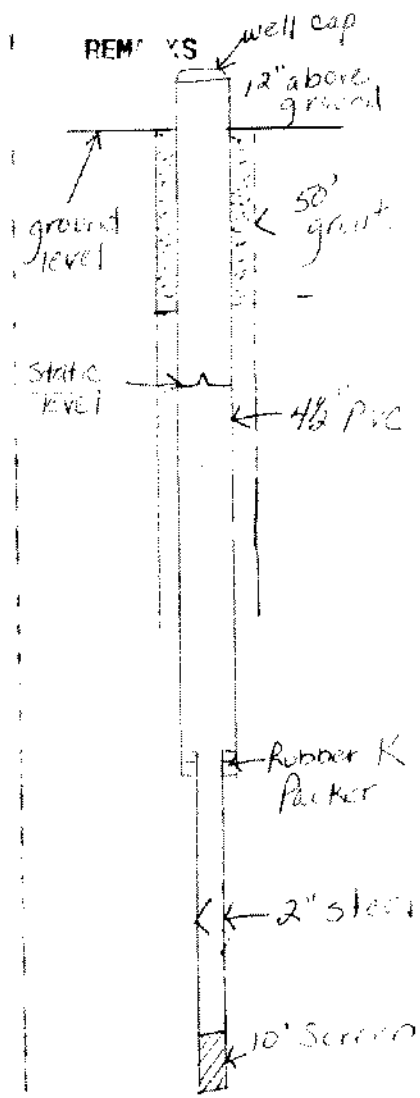

I certify that the information contained here is true and that this well was installed and constructed in accordance with the permit and further that the well complies with all applicable state and local regulations, ordinances and laws.

Name: King George Drilling
 Address: TRL 1 - Box 86K
Colonial Beach, VA 22443
 Phone: 1804 224-9130
 Driller's Signature: John Jordan - Shepherd
 Date: 4-12-95 Representing Kenneth W. Frank, Jr.
 Driller's Contractors License Number: 023065 A