

Sharon
7452
Fredericksburg Va 22404
WF 372-44018 (6660)
Rgn 372-4674

Commonwealth of Virginia
Uniform Water Well Completion Report

Owner J. M. N. Willis
Address 1106 Progress Lane Street
Fredericksburg Va 22401
Phone 373-7288
Location Bella Flaming #3
204 -> 7/0 M. East Potomac Creek Est. - Driveway, on left - Waterfront
Well Classification IIIA IIIB IIIC IV

Tax Map ID A8-17-11
VDH Permit W-93-194
VWCB Permit _____
VWCB ID _____
County STAFFORD
6/30/93 Daniel Jusselyn
7/93 T.T. Thompson

* Well Data *

General Information

Drilling Method Mud Rotary
Depth to Bedrock _____
State Water Level 25
Well Contaminated (Y or N) _____

Date Completed 7/8/93
Yield 80 (GPM)
Stabilized Water Level 40
Disinfectant Used _____

Total Depth of Well 200
Length of Test 2 Hrs
Natural Flow (Rate) _____
Amount Used _____

Casing

From 1 To 180
Size 4 1/2 Material PVC
Weight/Schedule SDR 17

From 172 To 189
Size 2 Material galvanized steel
Weight/Schedule Schedule 40

From _____ To _____
Size _____ Material _____
Weight/Schedule _____

Gravel Pack

From _____ To _____
Gravel size 7/8" From 0 to 180 ft.
From 0 To 50'
Bore Hole Size 7 7/8" 7/8/93
Type Bentonite
Method Pressure Grouting

From _____ To _____
Bore Hole Size _____
Type _____
Method _____

From _____ To _____
Bore Hole Size _____
Type _____
Method _____

Water Zones or Screened Intervals

From 189 To 200
Mesh Size 0.20 Diam Stainless Steel
From _____ To _____
Mesh Size _____ Diam _____

Approx water zone
From 187' To 199'
Mesh Size _____ Diam _____
From _____ To _____
Mesh Size _____ Diam _____

From _____ To _____
Mesh Size _____ Diam _____
From _____ To _____
Mesh Size _____ Diam _____

* Use Data *

Private Well: Domestic Agricultural _____ Industrial _____ Monitoring _____
Public Well: Community _____ Non Community _____

* Abandonment Information *

Bored or Dug Wells

Casing Removed, Y or N? _____
If Y, Depth to which casing was removed: _____
Depth and Type of Fill: _____
Source of Fill _____
Bentonite Plugs From _____ to _____ From _____ to _____

Wells other than Bored Wells

Casing removed, Y or N? _____
Depth to which casing was removed: _____
Applicable, depth(s), and type of gravel/sand fill _____
Source of gravel or sand: _____
Cement: From _____ to _____ From _____ to _____


Method of permanently marking location: _____

Installed watertight top
Suggest setting pump @ approx. 60 ft.
Well pumped 30 G.P.M @ 60' on 7/8/93

L. Phillip Johnson
 J. M. H. Willis
 Belle Plains #3

* Drillers Log *

Depth	Description of Formation or Sediment	Remarks
0	2	Top soil
2	25	Brown & Grey Clay
25	35	Grey Sandy Clay
35	70	Grey Sand
70	72	Sandy Grey Clay
72	110	Black Sand
110	160	Sandy Grey Clay
160	170	Grey Sand
170	187	Grey Sandy clay
187	199	Grey Sand - water zone
199	200	Grey clay

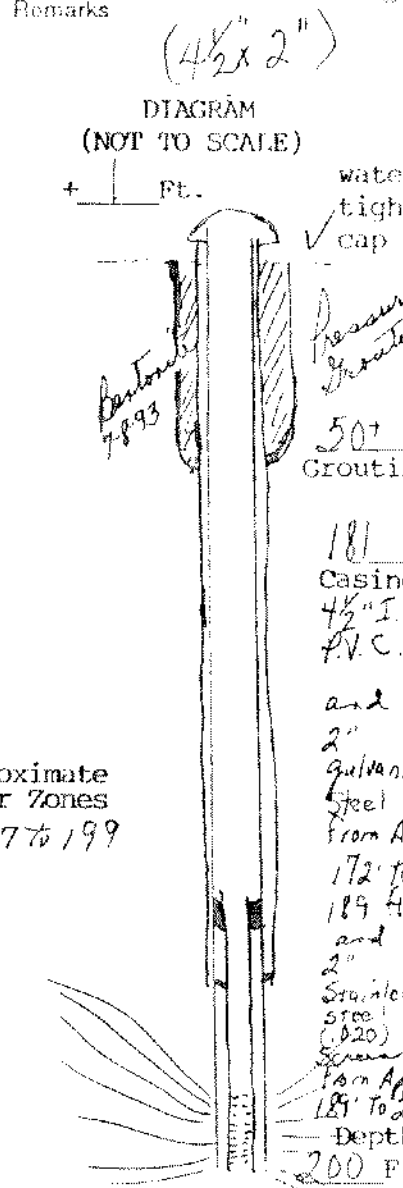

(Use additional Sheets if necessary)

I certify that the information contained here is true and that this well was installed and constructed in accordance with the permit and further that the well complies with all applicable state and local regulations, ordinances and laws.

Name: JOHN L. DANIELSON, JR., INC.
 Address: 4616 HOOD DRIVE
 FREDERICKSBURG, VIRGINIA 22408
 Phone: (703) 898-6025 / 898-9355

Signature: *John L. Danielson, Jr.*
 Date: 1/6/93 Representing: JOHN L. DANIELSON, JR., INC.

Virginia Contractors License Number: CLASS A 2701 014084A H/H WMC