

**Commonwealth of Virginia  
Uniform Water Well Completion Report**

Permit issued to:

Owner Ray Stoner Holman Willis Tax Map ID 48-24-D  
 Address 305 Wood Landing Rd. Fredericksburg Va. 22405 608 Waterberry Drive VDH Permit WS-93-174  
 Phone 373-7003 373-0970 VWCB Permit \_\_\_\_\_  
 Location Zapazaws #1 off rd / Zapazaws Lane County Stafford VWCB ID \_\_\_\_\_  
183C 305 Wood Landing Road Approx 1 M. South of Inter of 600 7/93 Ashton Wright  
 Well Classification IIIA IIIB IIIC IV 712 717

\* Well Data \*

**General Information**

Drilling Method Air Rotary Date Completed 2/8/95 Total Depth of Well 140'  
 Depth to Bedrock \_\_\_\_\_ Yield 20 (GPM) Length of Test approx 1 Hr.  
 Static Water Level approx 20' Stabilized Water Level 25 Natural Flow (Rate) \_\_\_\_\_  
 Well Disinfected (Y or N) \_\_\_\_\_ Disinfectant Used \_\_\_\_\_ Amount Used \_\_\_\_\_

**Casing**  
 From 1 To 59 From 55 To 110 From 130 To 140  
 Size 6 1/4 Material P.V.C. Size 4" Material P.V.C. Size 4" Material P.V.C.  
 Weight/Schedule SDR 27 Weight/Schedule Sch 40 Weight/Schedule Sch 40

**Gravel Pack**  
 From \_\_\_\_\_ To \_\_\_\_\_ From \_\_\_\_\_ To \_\_\_\_\_ From \_\_\_\_\_ To \_\_\_\_\_  
 Hole size 10" from 0 to 50 ft. 7/8" from 50 to 59 ft. 6/8" from 59 to 140 ft.  
 Grout  
 From 0 To 2/9/95 From \_\_\_\_\_ To \_\_\_\_\_ From \_\_\_\_\_ To \_\_\_\_\_  
 Bore Hole Size 10" Bore Hole Size \_\_\_\_\_ Bore Hole Size \_\_\_\_\_  
 Type Bentonite Type \_\_\_\_\_ Type \_\_\_\_\_  
 Method Pressure Grouting Method \_\_\_\_\_ Method \_\_\_\_\_

**Water Zones or Screened Intervals**  
 From 110 To 130 From \_\_\_\_\_ To \_\_\_\_\_ From \_\_\_\_\_ To \_\_\_\_\_  
 Mesh Size 1020 Diam 4" P.V.C. Mesh Size \_\_\_\_\_ Diam \_\_\_\_\_ Mesh Size \_\_\_\_\_ Diam \_\_\_\_\_  
 From \_\_\_\_\_ To \_\_\_\_\_ From \_\_\_\_\_ To \_\_\_\_\_ From \_\_\_\_\_ To \_\_\_\_\_  
 Mesh Size \_\_\_\_\_ Diam \_\_\_\_\_ Mesh Size \_\_\_\_\_ Diam \_\_\_\_\_ Mesh Size \_\_\_\_\_ Diam \_\_\_\_\_

\* Use Data \*

Private Well: Domestic  Agricultural \_\_\_\_\_ Industrial \_\_\_\_\_ Monitoring \_\_\_\_\_  
 Public Well: Community \_\_\_\_\_ Non Community \_\_\_\_\_

\* Abandonment Information \*

**Bored or Dug Wells**  
 Casing Removed, Y or N? \_\_\_\_\_  
 If Y, Depth to which casing was removed: \_\_\_\_\_  
 Depth and Type of Fill: \_\_\_\_\_  
 Source of Fill \_\_\_\_\_  
 Bentonite Plugs: From \_\_\_\_\_ to \_\_\_\_\_ From \_\_\_\_\_ to \_\_\_\_\_

**Wells other than Bored Wells**  
 Casing removed, Y or N? \_\_\_\_\_  
 Depth to which casing was removed: \_\_\_\_\_  
 Applicable, depth(s), and type of gravel/sand fill: \_\_\_\_\_  
 Source of gravel or sand: \_\_\_\_\_  
 Cement: From \_\_\_\_\_ to \_\_\_\_\_ From \_\_\_\_\_ to \_\_\_\_\_

Method of permanently marking location: \_\_\_\_\_  
 Installed watertight top  
 Suggest setting pump @ approx. 65 ft.  
You will encounter 4" casing @ approx. 55 Ft.  
Suggest keeping torque arrestors & centralizers out of 4" casing.

Name: 9008 Fletcher  
 Title: Tracer  
 Name of Company/Corporation/Individual: 9008 Fletcher


Ray Stone  
Zapazaw #1  
Stafford 712 off 600 & 218 (Zapazaw Lane)  
 305 Wood Landing Rd. Fburg 22405. Drillers Log

Depth Description of Formation or Sediment Remarks

0	10	Sandy Red Clay
10	30	Yellow Sand
30	50	Black Sand
50	59	Blue Clay
59	115	Red Clay
115	128	Grey Sand
128	140	Brown Clay



Approximate Water Zones  
 115 to 120

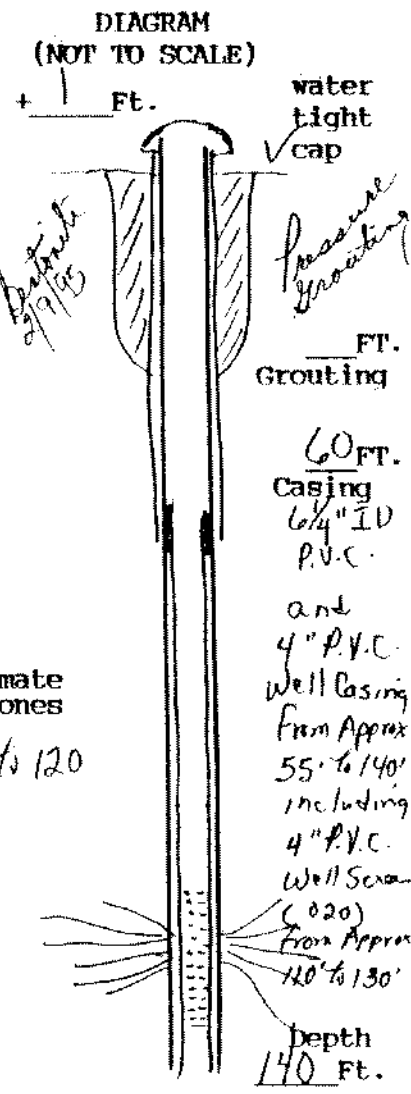

(User additional Sheets if necessary)

I certify that the information contained here is true and that this well was installed and constructed in accordance with the permit and further that the well complies with all applicable state and local regulations, ordinances and laws.

Name JOHN L. DANIELSON, JR., INC.  
 Address 4616 HOOD DRIVE  
FREDERICKSBURG, VIRGINIA 22408  
 Phone (703) 898-6025 / 898-9355  
 Drillers Signature [Signature]  
 Date 2/9/95 Representing JOHN L. DANIELSON, JR., INC.  
 Virginia Contractors License Number CLASS A 2701 014084A H/H WWC