

ENDING

TACHED

FAUCET SHOULD  
SAMPLE-READ THESE INSTRUCTIONS  
ology Collection Program

830891-5533

P. 01

### Commonwealth of Virginia Uniform Water Well Completion Report

Well named to: Wesley & Yvonne Salvador / Sheila A. Conje  
 Tax Map ID 48-19 (Part of)  
 SS P.O. Box 17375 VDH Permit WS-93-262  
Fredericksburg, Va. 22404 VWCB Permit \_\_\_\_\_  
Shop 920-6568 9829842 VWCB ID \_\_\_\_\_  
881 Belle Plains Road 1604 / Adj. to Justice W. H. H. County STAFFORD  
(881 Belle Plains Rd.) 9/29/93 Rob. Snyder  
 Classification IIIA IIIB  IIIC IV 10/1/93 T.T. Thompson  
 \* Well Data \* SFF

General Information  
 Drilling Method Mud Rotary Date Completed 8/24/95 Total Depth of Well 230  
 Depth to Bedrock \_\_\_\_\_ Yield 60 (GPM) Length of Test approx 1 Hr  
 Static Water Level approx 10' Stabilized Water Level approx 100' Natural Flow (Rate) \_\_\_\_\_  
 Disinfected (Y or N) \_\_\_\_\_ Disinfectant Used \_\_\_\_\_ Amount Used \_\_\_\_\_

Casing  
 Size 1 1/2 To 200 From 220 To 230 From \_\_\_\_\_ To \_\_\_\_\_  
 Material P.V.C. Size 48 Material P.V.C. Size \_\_\_\_\_ Material \_\_\_\_\_  
 Weight/Schedule SDR 17 Weight/Schedule SDR 17 Weight/Schedule \_\_\_\_\_

Well Pack  
 Size 50 To 230 From \_\_\_\_\_ To \_\_\_\_\_ From \_\_\_\_\_ To \_\_\_\_\_  
 size \_\_\_\_\_ " from \_\_\_\_\_ to \_\_\_\_\_ ft. " from \_\_\_\_\_ to \_\_\_\_\_ ft.  
 Bore Hole Size 7 1/8 To 50+ From \_\_\_\_\_ To \_\_\_\_\_ From \_\_\_\_\_ To \_\_\_\_\_  
 Type Barite Bore Hole Size \_\_\_\_\_ Bore Hole Size \_\_\_\_\_  
 Method Pressure Monitoring Method \_\_\_\_\_ Method \_\_\_\_\_

Zones or Screened Intervals  
 From 200 To 220 From 202 To 218 From \_\_\_\_\_ To \_\_\_\_\_  
 Mesh Size 42" (P.V.C.) Mesh Size \_\_\_\_\_ Diam \_\_\_\_\_ Mesh Size \_\_\_\_\_ Diam \_\_\_\_\_  
 From \_\_\_\_\_ To \_\_\_\_\_ From \_\_\_\_\_ To \_\_\_\_\_ From \_\_\_\_\_ To \_\_\_\_\_  
 Mesh Size \_\_\_\_\_ Diam \_\_\_\_\_ Mesh Size \_\_\_\_\_ Diam \_\_\_\_\_

\* Use Data \*

Well: Domestic  Agricultural \_\_\_\_\_ Industrial \_\_\_\_\_ Monitoring \_\_\_\_\_  
 Well: Community \_\_\_\_\_ Non Community \_\_\_\_\_

Sat. 8/26 #H95 11148  
 3/4 H.P. 10 G.P.M. Goulds Submer.  
 WX 250 (44 gal) Tank


\* Abandonment Information \*

For Dug Wells  
 Casing removed, Y or N? \_\_\_\_\_  
 Depth to which casing was removed: \_\_\_\_\_  
 Material and Type of Fill: \_\_\_\_\_  
 Source of Fill: \_\_\_\_\_  
 Cement Plugs: From \_\_\_\_\_ to \_\_\_\_\_ From \_\_\_\_\_ to \_\_\_\_\_  
 Method of permanently marking location: \_\_\_\_\_  
 Installed watertight top \_\_\_\_\_  
 Last setting pump @ approx. 120 ft.

Wells other than Bored Wells  
 Casing removed, Y or N? \_\_\_\_\_  
 Depth to which casing was removed: \_\_\_\_\_  
 Applicable, depth(s), and type of gravel/sand fill: \_\_\_\_\_  
 Source of gravel or sand: \_\_\_\_\_  
 Cement: From \_\_\_\_\_ to \_\_\_\_\_ From \_\_\_\_\_ to \_\_\_\_\_

604  
 881 Belle Plains Road  
 Stafford / Adj. to Judge Wilkes  
 Driller's Log

Depth	Description of Formation or Sediment	Remarks
0	10	Red Clay
10	60	Blue Marl
60	90	Black Sand
90	202	Blue Clay
12	218	Gray Sand
2	230	Brown Clay

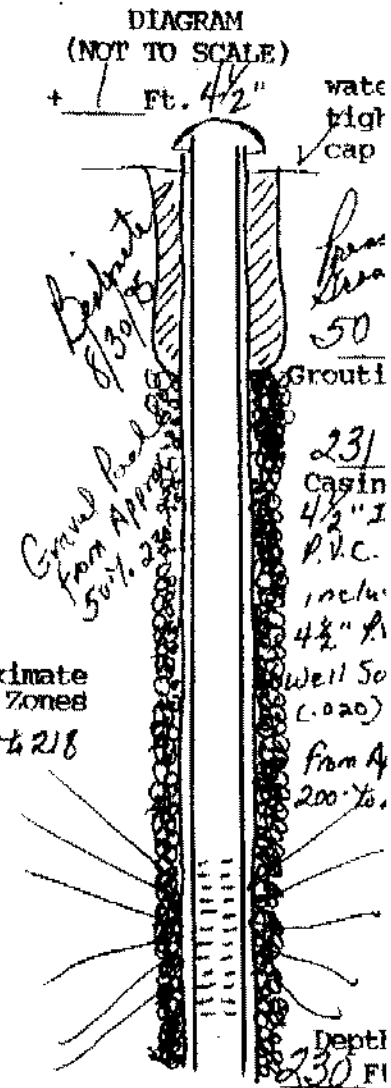

(Use additional Sheets if necessary)

I certify that the information contained here is true and that this well was installed and constructed in accordance with the permit and other that the well complies with all applicable state and local regulations, ordinances and laws.

Company JOHN L. DANIELSON, JR., INC.  
 Address 4616 HOOD DRIVE  
FREDERICKSBURG, VIRGINIA 22408  
 Phone (703) 898-6025 / 898-9355

Driller's Signature John L. Danielson, Pres.  
 Date 8/24/85 Representing JOHN L. DANIELSON, JR., INC.

Virginia Contractors License Number CLASS A 2701 014084A H/H WWC