

George Barboza
Potosi Creek Est #12
 STAFFORD
 off 609/ Belle Meade road

Department of Health
 Department of Virginia
 of Company/Corporation
 Name: 17340


Drillers Log

Depth	Description of Formation or Sediment
0 3	Sandy Clay
3 6	Sand & Gravel
6 10	Grey Clay
10 50	Black Sand
50 80	Grey Clay
80 100	Brown Clay
100 160	Grey Sandy Clay
160 170	Brown Clay
170 190	Sandy Grey Clay
190 198	Sandstone
198 200	Grey Clay

Water Zone

Remarks (4 1/2" x 2")

DIAGRAM (NOT TO SCALE)

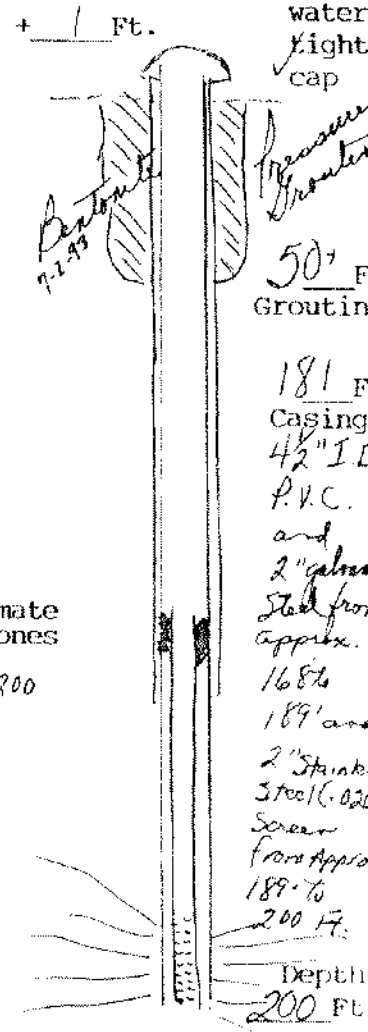

Approximate Water Zones 190 to 200

(User additional Sheets if necessary)

I certify that the information contained here is true and that this well was installed and constructed in accordance with the permit and further that the well complies with all applicable state and local regulations, ordinances and laws.

Name: JOHN L. DANIELSON, JR., INC.
 Address: 4616 HOOD DRIVE
FREDERICKSBURG, VIRGINIA 22408
 Phone: (703) 898-6025 / 898-9355

Drillers Signature: George T. Danielson, Jr.
 Date: 7/2/93 Representing JOHN L. DANIELSON, JR., INC.

Virginia Contractors License Number CLASS A 2701 014084A H/H WWC