

Commonwealth of Virginia Uniform Water Well Completion Report

Owner Nibadita Mohanty
 Address 19135 Partridge Wood Drive
Germantown, MD
 Phone _____
 Location Rt 621 (Marlboro Point)

Tax Map ID 49-17M
 VDH Permit SWP-95-171
 VWCB Permit _____
 VWCB ID _____
 County Stafford

* Well Data *

General Information

Drilling Method <u>Mud rotary</u>	Date Completed <u>10-13-95</u>	Total Depth of Well <u>205 ft</u>
Depth to Bedrock <u>N/A</u>	Yield <u>45</u> (GPM)	Length of Test <u>2 hr</u>
Static Water Level <u>80</u>	Stabilized Water Level _____	Natural Flow (Rate) _____
Well Disinfected (Y or N) <u>y</u>	Disinfectant Used <u>Gran chlor</u>	Amount Used <u>2 cups</u>

Casing

From <u>+1</u> to <u>204</u>	From _____ to _____	From _____ to _____
Size <u>4 1/2"</u> Material <u>PVC</u>	Size _____ Material _____	Size _____ Material _____
Weight/Schedule <u>Sch 40</u>	Weight/Schedule _____	Weight/Schedule _____

Gravel Pack

From <u>204</u> to <u>50</u>	From _____ to _____	From _____ to _____
------------------------------	---------------------	---------------------

Grout 50 0


From _____ to _____	From _____ to _____	From _____ to _____
Bore Hole Size <u>8"</u>	Bore Hole Size _____	Bore Hole Size _____
Type <u>Neat</u>	Type _____	Type _____
Method <u>Pressure</u>	Method _____	Method _____

Water Zones or Screened Intervals

From <u>180</u> to <u>200</u>	From _____ to _____	From _____ to _____
Mesh Size <u>0.020</u> Diam. <u>4 1/2"</u>	Mesh Size _____ Diam. _____	Mesh Size _____ Diam. _____
From _____ to _____	From _____ to _____	From _____ to _____
Mesh Size _____ Diam. _____	Mesh Size _____ Diam. _____	Mesh Size _____ Diam. _____

* Use Data *

Private Well: Domestic Agricultural _____ Industrial _____ Monitoring _____
 Public Well: Community _____ Non Community _____

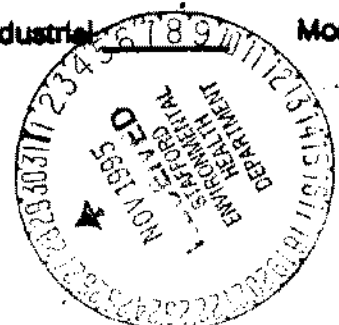

Statement
 Dept of Virginia
 Health & Human Resources
 Permit Corporation /

DRILLERS LOG
 (Use additional sheets if necessary)

Depth	Description of Formation or Sediment	
0-20	Sandy clay	
20-31	Clay	
31-40	Sand	
40-95	Clay	
95-120	Sand	
120-180	Clay	Fine
180-200	Gray sand	Water bearing
200-204	Clay	

I certify that the information contained here is true and that this well was installed and constructed accordance with the permit and further that the well complies with all applicable state and local regulations, ordinances and laws.

Drilling
 Contractor Van's Construction Co., Inc.
 Address P.O. Box 3306
Fredericksburg, Va. 22402
 Phone (703) 373-7502
 Drillers Signature John Slater Date 10-13-95
 Representing Van's Const Co Inc
 Virginia Contractors License Number 2701 018610A