

**Commonwealth of Virginia
Uniform Water Well Completion Report**

Owner Bernard Chandler
 Address 9729 Appertree Road
Spotsylvania, Va. 22553
 Phone 371-14056
 Location Japazona 1819 (off 712 Wood Landing Rd.)

Tax Map ID 49-39-1819
 VDH Permit SWP-96-330
 VWCB Permit _____
 VWCB ID _____
 County Stafford
9/16/96 Dalton B. Wright
CRC DSC

Well Classification IIIA _____ IIIB IIIC _____ IV _____
 * Well Data *

General Information

Drilling Method Air Rotary
 Depth to Bedrock _____
 Static Water Level 20
 Well Disinfected (Y or N) _____

Date Completed 5/13/97
 Yield 30 (GPM)
 Stabilized Water Level _____
 Disinfectant Used _____

Total Depth of Well 100'
 Length of Test approx 1 Hr.
 Natural Flow (Rate) _____
 Amount Used _____

Casing

From +1 To 67
 Size 6 1/4 Material P.V.C.
 Weight/Schedule S.D.R. 27

From 60 To 75
 Size 4" Material P.V.C.
 Weight/Schedule Sch. 40

From 95 To 100
 Size 4" Material P.V.C.
 Weight/Schedule Sch 40

Gravel Pack

From _____ To _____
 Hole size 10" from 0 to 50ft.

From _____ To _____
 Hole size 7 7/8" from 50 to 67ft.

From _____ To _____
 Hole size 6 1/8" from 67 to 100ft.

Grout
 From 0 To 50'
 Bore Hole Size 10" 5/18/97
 Type Bentonite
 Method Pressure Grouting

From _____ To _____
 Bore Hole Size _____
 Type _____
 Method _____

From _____ To _____
 Bore Hole Size _____
 Type _____
 Method _____

Water Zones or Screened Intervals

From 75 To 95
 Mesh Size .020 Diam 4" (P.V.C.)
 From _____ To _____
 Mesh Size _____ Diam _____

approx water zone
 From 75 To 95
 Mesh Size _____ Diam _____
 From _____ To _____
 Mesh Size _____ Diam _____

From _____ To _____
 Mesh Size _____ Diam _____
 From _____ To _____
 Mesh Size _____ Diam _____

*** Use Data ***

Private Well: Domestic Agricultural _____ Industrial _____ Monitoring _____
 Public Well: Community _____ Non Community _____

*** Abandonment Information ***

Bored or Dug Wells

Casing Removed, Y or N? _____
 If Y, Depth to which casing was removed: _____
 Depth and Type of Fill: _____
 Source of Fill _____
 Bentonite Plugs: From _____ to _____ From _____ to _____

Wells other than Bored Wells

Casing removed, Y or N? _____
 Depth to which casing was removed: _____
 Applicable, depth(s), and type of gravel/sand fill: _____
 Source of gravel or sand: _____
 Cement: From _____ to _____ From _____ to _____


Method of permanently marking location: _____
 Installed watertight top
 Suggest setting pump @ approx. 65 ft.

Berzie Chandler

Japazawa 18 1/2 19

Stafford
off #712 / (Woodstanding Road)
Drillers Log

Depth	Description of Formation or Sediment	Remarks
0	10	Sandy Red Clay
10	30	Yellow Sandy clay
30	50	Black Sand
50	70	Blue Clay
70	75	Red Clay
75	95	Grey Sand - water zone
95	100	Brown Clay

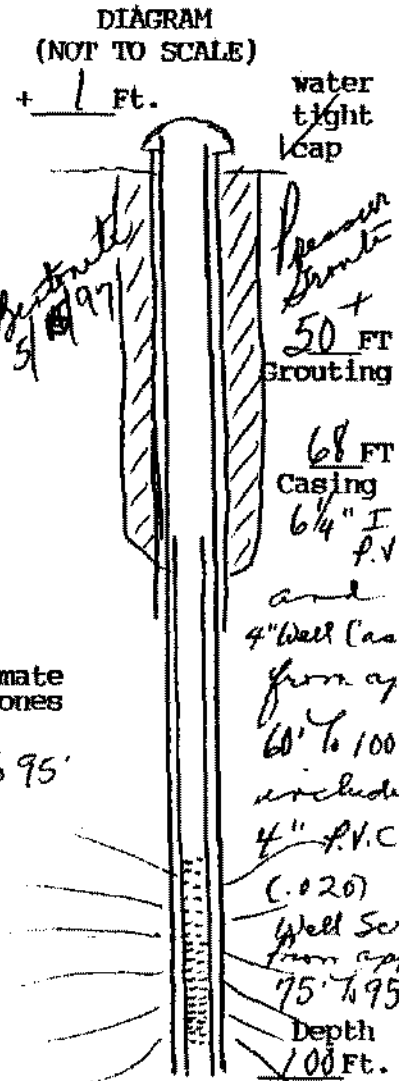

Approximate
Water Zones
75' to 95'

(User additional Sheets if necessary)

I certify that the information contained here is true and that this well was installed and constructed in accordance with the permit and further that the well complies with all applicable state and local regulations, ordinances and laws.

Name JOHN L. DANIELSON, JR., INC.
Address 4616 HOOD DRIVE
FREDERICKSBURG, VIRGINIA 22408
Phone 540 (703) 898-6025 / 898-9355

Drillers Signature John L. Danielson, Pres.
Date 5/15/97 Representing JOHN L. DANIELSON, JR., INC.

Virginia Contractors License Number CLASS A 2701 014084A H/H WWC