

**Commonwealth of Virginia  
Uniform Water Well Completion Report**

Owner J. P. Caldwell Tax Map ID 49-39-E  
 Address 345 Woodlanding Rd. VIII Permit WIS-93-234  
Fredericksburg, VA 22405 VWCB Permit \_\_\_\_\_  
 Phone (703) 313-1232 VWCB ID \_\_\_\_\_  
 Location Rte. 712, Woodlanding Rd. County Stafford  
 Well Classification IIIA \_\_\_\_\_ IIIB  IIIC \_\_\_\_\_ IV \_\_\_\_\_

\* Well Data \*

**General Information**

Drilling Method Rotary Date Completed 2-17-94 Total Depth of Well 196 ft.  
 Depth to Bedrock \_\_\_\_\_ Yield 30 (GPM) Length of Test 4 HRS.  
 Static Water Level 35 Stabilized Water Level 65 Natural Flowrate \_\_\_\_\_  
 Well Disinfected (Y/N) Y Disinfectant Used chlorox Amount Used 50 PPM

**Casing**

From <u>1</u> to <u>154</u>	From <u>154</u> to <u>186</u>	From _____ to _____
Size <u>4 1/2"</u> Material <u>PVC</u>	Size <u>2"</u> Material <u>Galv.</u>	Size _____ Material _____
Weight/Schedule <u>40</u>	Weight/Schedule <u>40</u>	Weight/Schedule _____

**Gravel Pack**

From \_\_\_\_\_ to \_\_\_\_\_ From \_\_\_\_\_ to \_\_\_\_\_ From \_\_\_\_\_ to \_\_\_\_\_

**Grout**

From <u>0</u> to <u>50</u>	From <u>50</u> to <u>154</u>	From <u>154</u> to <u>196</u>
Bore Hole Size <u>8"</u>	Bore Hole Size <u>7"</u>	Bore Hole Size <u>3 7/8"</u>
Type <u>Bentonite Clay</u>	Type _____	Type _____
Method <u>Pressure</u>	Method _____	Method _____

**Water Zones or Screened Intervals**

From <u>186</u> to <u>196</u>	From _____ to _____	From _____ to _____
Mesh Size <u>15</u> Diam. <u>2"</u>	Mesh Size _____ Diam. _____	Mesh Size _____ Diam. _____
From _____ to _____	From _____ to _____	From _____ to _____
Mesh Size _____ Diam. _____	Mesh Size _____ Diam. _____	Mesh Size _____ Diam. _____

\* Use Data \*

Private Well: Domestic  Agricultural \_\_\_\_\_ Industrial \_\_\_\_\_ Monitoring \_\_\_\_\_  
 Public Well: Community \_\_\_\_\_ Non Community \_\_\_\_\_

\* Abandonment Information \*

**Bored or Dug Wells**

Casing Removed, Y or N?: \_\_\_\_\_  
 If Y, Depth Removed: \_\_\_\_\_  
 Depth and Type of Fill: \_\_\_\_\_  
 Source of Fill: \_\_\_\_\_  
 Bentonite Plugs: From \_\_\_\_\_ to \_\_\_\_\_  
 From \_\_\_\_\_ to \_\_\_\_\_


**Wells other than Bored Wells**

Casing Removed, Y or N?: \_\_\_\_\_  
 If Y, Depth Removed: \_\_\_\_\_  
 Depth and type of Fill: \_\_\_\_\_  
 Source of Gravel or Sand: \_\_\_\_\_  
 Cement: From \_\_\_\_\_ to \_\_\_\_\_  
 From \_\_\_\_\_ to \_\_\_\_\_

Method of permanently marking location: \_\_\_\_\_

**\*DRILLERS LOG\***

DEPTH	DESCRIPTION OF FORMATION OR SEDIMENT
0-7	Brown clay
7-35	Sand
35-78	Blue clay & sand
78-115	Blue & gray clay
115-137	Blue & white sand
137-160	Blue clay
160-180	Green & brown clay
180-196	Blue sand

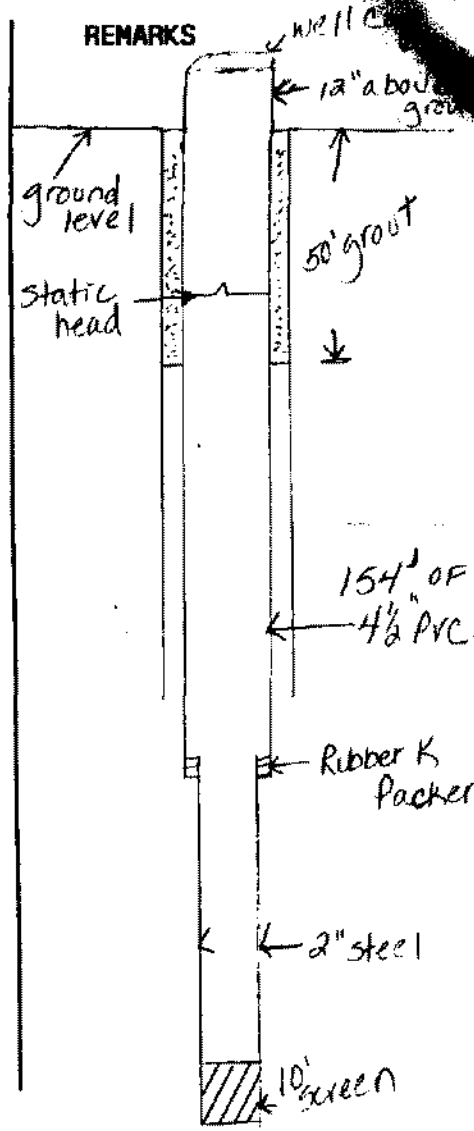

I certify that the information contained here is true and that this well was installed and constructed in accordance with the permit and further that the well complies with all applicable state and local regulations, ordinances and laws.

Name King George Drilling  
 Address 1 Rt. 1 - Box 86K  
Colonial Beach, VA 22443  
 Phone (804) 224-9130

Driller's Signature *Alane Jordan-Shepherd*  
 Date 2-17-94 Representing Kenneth Frank, Jr.

Virginia Contractors License Number 023065