

# Commonwealth of Virginia Uniform Water Well Completion Report

Owner Maurice Burton  
 Address 716 Forbes Street  
Fredericksburg, VA 22405  
 Phone (703) 373-5045  
 Location Lot #1, Burton Family Sub., on Rt. 627, Approx.  
1/2 mile before Harrell Road, on Left.

Tax Map ID 54-2C-1  
 VDH Permit 189-89-41  
 VWCB Permit \_\_\_\_\_  
 VWCB ID \_\_\_\_\_  
 County Stafford

### \* Well Data \*

#### General Information

Drilling Method <u>Mud Rotary</u>	Date Completed <u>2-17-92</u>	Total Depth of Well <u>210</u>
Depth to Bedrock <u>N/A</u>	Yield <u>30</u> (GPM)	Length of Test <u>2Hr.</u>
Static Water Level <u>60</u>	Stabilized Water Level _____	Natural Flow (Rate) <u>-</u>
Well Disinfected (Y or N) <u>y</u>	Disinfectant Used <u>Chlor. Tablets</u>	Amount Used <u>20</u>

#### Casing

From <u>+1</u> to <u>210</u>	From _____ to _____	From _____ to _____
Size <u>4</u> Material <u>PVC</u>	Size _____ Material _____	Size _____ Material _____
Weight/Schedule <u>sch 40</u>	Weight/Schedule _____	Weight/Schedule _____

#### Gravel Pack

From <u>210</u> to <u>51</u>	From _____ to _____	From _____ to _____
------------------------------	---------------------	---------------------

#### Grout

From <u>51</u> to <u>0</u>	From <u>0</u> to <u>210</u>	From _____ to _____
Bore Hole Size <u>8"</u>	Bore Hole Size <u>8"</u>	Bore Hole Size _____
Type <u>Neat</u>	Type _____	Type _____
Method <u>Pressure</u>	Method _____	Method _____

#### Water Zones or Screened Intervals

From <u>130</u> to <u>150</u>	From <u>170</u> to <u>205</u>	From _____ to _____
Mesh Size _____ Diam. _____	Mesh Size _____ Diam. _____	Mesh Size _____ Diam. _____
From _____ to _____	From _____ to _____	From _____ to _____
Mesh Size _____ Diam. _____	Mesh Size _____ Diam. _____	Mesh Size _____ Diam. _____


### \* Use Data \*

Private Well: Domestic X Agricultural \_\_\_\_\_ Industrial \_\_\_\_\_ Monitoring \_\_\_\_\_  
 Public Well: Community \_\_\_\_\_ Non Community \_\_\_\_\_

**Drillers Log \***  
(Use additional sheets if necessary)

State Department of Health  
"Don't Stop at the State Line"

Depth	Description of Formation or Sediment	Remarks
0-10	Clay	
10-30	Yellow Sand	
30-40	Blue Marl	
40-65	Sand Stone	
65-72	Sand	
72-100	Clay	
100-110	Sand and Gravel	
110-120	Clay	
120-125	Sand Stone	
125-150	Sand and Gravel	
150-170	Sand Stone	
170-205	Sand and Gravel	
205-210	Clay	

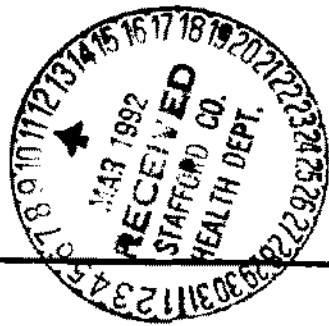

I certify that the information contained here is true and that this well was installed and constructed in accordance with the permit and further that the well complies with all applicable state and local regulations, ordinances and laws.

**Drilling**  
 Contractor Van's Construction Co., Inc.  
 Address P.O. Box 3306  
Fredericksburg, VA 22402  
 Phone (703) 373-7502

Drillers Signature *Vernon Wilson* Date 3-9-92  
 Representing \_\_\_\_\_  
 Virginia Contractors License Number \_\_\_\_\_

Well Cap:  
 Midwest Dicken mfg.  
 WTCC-4