

Interpress Inc
Prosope Rd
Federicksburg, VA 22405 Commonwealth of Virginia
371-9480 Fax 301-6778 Uniform Water Well Completion Report
cell 840-5115

Owner Dana Smith
Address 1 Woodberry Court
Federicksburg, VA 22405
Phone 373-4919
Location M Canterbury Lane off Belle Plain #218

Tax Map ID 55-194-H
VDH Permit SWP-01-469
VWCB Permit _____
VWCB ID _____
County Stafford
11/1/01 John Morley
MEK

Well Classification IIIA _____ IIIB IIIC _____ IV _____
* Well Data *

General Information

Drilling Method 5" Med Rotary
Depth to Bedrock _____
Static Water Level 60'
Well Disinfected (Y or N) _____

Date Completed 4/29/02
Yield 30 (GPM)
Stabilized Water Level 180'
Disinfectant Used _____

Total Depth of Well 250'
Length of Test approx 1 Hr.
Natural Flow (Rate) _____
Amount Used _____

Casing

From +1 To 220
Size 4 1/2" Material P.V.C.
Weight/Schedule SDR

From 240 To 250
Size 4 1/2" Material P.V.C.
Weight/Schedule SDR 17

From _____ To _____
Size _____ Material _____
Weight/Schedule _____

Gravel Pack

From 60 To 250

From _____ To _____

From _____ To _____

Hole size

7 1/8" from 0 to 250 ft.

" from _____ to _____ ft.

" from _____ to _____ ft.

Grout

From 0 To 60
Bore Hole Size 7 1/8"
Type Bentonite
Method Pressure Grouting

From _____ To _____
Bore Hole Size _____
Type _____
Method _____

From _____ To _____
Bore Hole Size _____
Type _____
Method _____

Water Zones or Screened Intervals

From 220 To 240
Mesh Size .020 Diam 4" (P.V.C.)
From _____ To _____
Mesh Size _____ Diam _____

From 220 To 240
Mesh Size _____ Diam _____
From _____ To _____
Mesh Size _____ Diam _____

From _____ To _____
Mesh Size _____ Diam _____
From _____ To _____
Mesh Size _____ Diam _____

* Use Data *

Private Well: Domestic Agricultural _____ Industrial _____ Monitoring _____
Public Well: Community _____ Non Community _____

* Abandonment Information *

Bored or Dug Wells

Casing Removed, Y or N? _____
If Y, Depth to which casing was removed: _____
Depth and Type of Fill: _____
Source of Fill _____
Bentonite Plugs: From _____ to _____ From _____ to _____

Wells other than Bored Wells

Casing removed, Y or N? _____
Depth to which casing was removed: _____
Applicable, depth(s), and type of gravel/sand fill: _____
Source of gravel or sand: _____
Cement: From _____ to _____ From _____ to _____


Method of permanently marking location:

Installed watertight top
Suggest setting pump @ approx. 200 ft.

Best Steel
Steel Enterprises
Dava South
M^cCauley Lane
Stafford
off Bell Plains * Drillers Log *
off # 218

Depth Description of Formation or Sediment Remarks

0	15	Sandy Red Clay
15	70	Grey clay
70	85	Brown clay
85	180	Black Sand & Shells
180	190	Sandy Grey clay
190	205	Sand
205	210	Sandy Grey clay
210	245	Sand - water zone
245	250	Sandstone

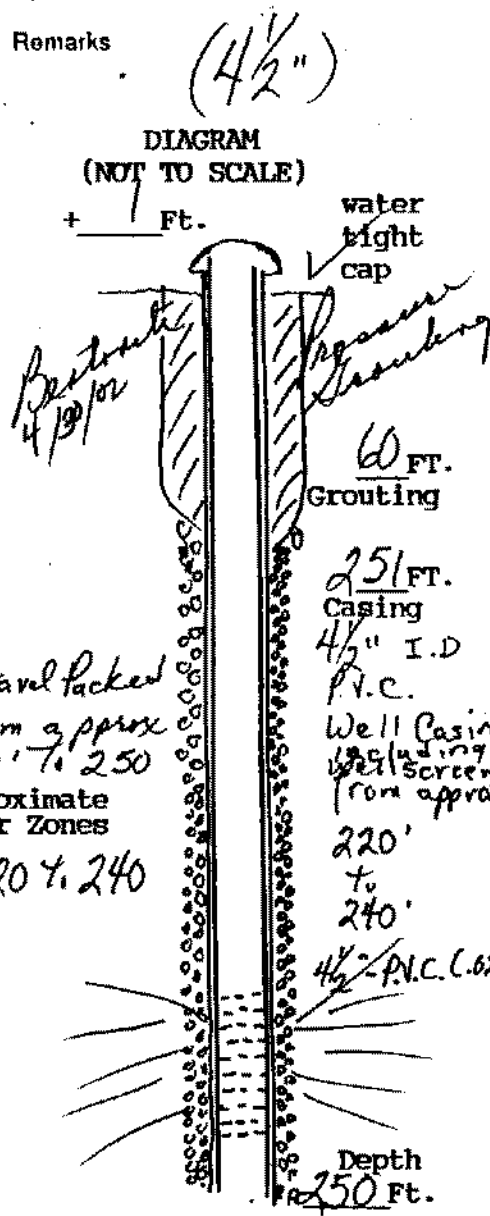

(Use additional Sheets if necessary)

I certify that the information contained here is true and that this well was installed and constructed in accordance with the permit and further that the well complies with all applicable state and local regulations, ordinances and laws.

Name JOHN L. DANIELSON, JR., INC.
Address 4616 HOOD DRIVE
FREDERICKSBURG, VIRGINIA 22408
Phone 540 (203) 898-6025 / 898-9355

Drillers Signature John L. Danielson, Pres
Date 4/30/02 Representing JOHN L. DANIELSON, JR., INC.

Virginia Contractors Licence Number CLASS A 2701 014084A II/II WWC