

Commonwealth of Virginia
Uniform Water Well Completion Report

Owner Mark Wilson
Address 93 B White Oak Rd.
Falmouth VA 22405
Phone 371-4580
Location Rte 216 To R00603 on R east cemetery
Well Classification IIIA _____ IIIB IIIC _____ IV _____

Tax Map ID 55-2222A
VMI Permit SWP-95-218
VWCB Permit _____
VWCB ID _____
County Stafford

* Well Data *

General Information

Drilling Method Rotary Date Completed 6-20-96 Total Depth of Well 247 Ft.
Depth to Bedrock _____ Yield 20 (GPM) Length of Test 4 hrs.
Static Water Level 100 Stabilized Water Level 125 Natural Flow (rate) _____
Well Disinfected (Y/N) Disinfectant Used chlorox Amount Used 50 PPM

Casing

From _____ to 230 From 227 to 232 From _____ to _____
Size 4 1/2" Material PVC Size 2" Material Galv. Size _____ Material _____
Weight/Schedule 40 Weight/Schedule 40 Weight/Schedule _____

Gravel Pack

From _____ to _____ From _____ to _____ From _____ to _____

Grout

From _____ to 50 From 50 to 230 From 230 to 247
Bore Hole Size 8" Bore Hole Size 7" Bore Hole Size 3 1/8"
Type Prepacked Type _____ Type _____
Method Pressure Method _____ Method _____

Water Zones or Screened Intervals

From 227 to 247 From _____ to _____ From _____ to _____
Mesh Size 15 Diam. 2" Mesh Size _____ Diam. _____ Mesh Size _____ Diam. _____
From _____ to _____ From _____ to _____ From _____ to _____
Mesh Size _____ Diam. _____ Mesh Size _____ Diam. _____ Mesh Size _____ Diam. _____

* Use Data *

Private Well: Domestic Agricultural _____ Industrial _____ Monitoring _____
Public Well: Community _____ Non Community _____


* Abandonment Information *

Bored or Dry Wells	Wells other than Bored Wells
Casing Removed, Y or N? _____	Casing Removed, Y or N? _____
If Y, Depth Removed: _____	If Y, Depth Removed: _____
Depth and Type of Fill: _____	Depth and Type of Fill: _____
Source of Fill: _____	Source of Gravel or Sand: _____
Bentonite Plugs: From _____ to _____	Cement: From _____ to _____
From _____ to _____	From _____ to _____

Method of permanently marking location: _____

DRILLERS LOG

DEPTH	DESCRIPTION OF FORMATION OR SEDIMENT
0 - 15	Brown & gray clay
15 - 45	Blue sand
45 - 80	Green clay
80 - 110	Black sand
110 - 130	Pink clay
130 - 227	Black sand & shells
227 - 247	Blue sand

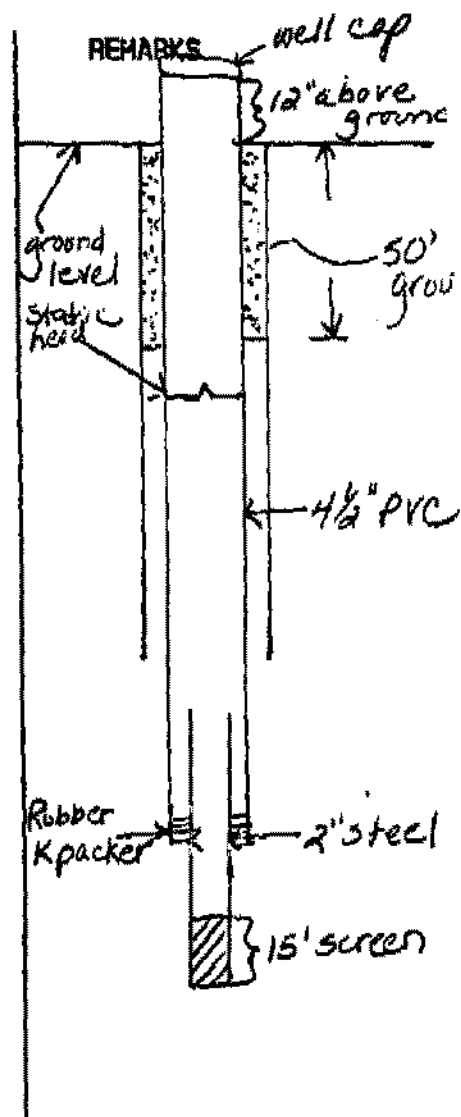

I certify that the information contained here is true and that this well was installed and constructed in accordance with the permit and further that the well complies with all applicable state and local regulations, ordinances and laws.

Name King George Drilling
 Address TR 1 - Box 88K
Colonial Beach, VA 22443
 Phone 804 224-9130

Driller's Signature [Signature]
 Date 6-20-96 Representing Kenneth M. Frank, Jr.

Virginia Contractors License Number 023065A