

**Commonwealth of Virginia  
Uniform Water Well Completion Report**

Owner William "Ron" Bryant  
 Address 3638 Stage Lane  
Roanoke, VA 24018  
 Phone 540-989-9456  
 Location 30 Lorenzo Drive - off Casson Rd #218

Tax Map ID 26 55-231B 9  
 VDH Permit W-01-629  
 VWCB Permit \_\_\_\_\_  
 VWCB ID \_\_\_\_\_  
 County Stafford  
11/24/01 John Mosley  
MK

Well Classification IIIA \_\_\_\_\_ IIIB  IIIC \_\_\_\_\_ IV \_\_\_\_\_  
 \* Well Data \*

**General Information**

Drilling Method Mud Rotary  
 Depth to Bedrock \_\_\_\_\_  
 Static Water Level 80'  
 Well Disinfected (Y or N) \_\_\_\_\_

Date Completed 2/7/01  
 Yield 30 (GPM)  
 Stabilized Water Level approx 180'  
 Disinfectant Used \_\_\_\_\_

Total Depth of Well 270  
 Length of Test approx 1 Hr.  
 Natural Flow (Rate) \_\_\_\_\_  
 Amount Used \_\_\_\_\_

**Casing**

From T1 To 240  
 Size 4 1/2" Material P.V.C.  
 Weight/Schedule SDR 27

From 260 To 270  
 Size 4 1/2" Material P.V.C.  
 Weight/Schedule \_\_\_\_\_

From \_\_\_\_\_ To \_\_\_\_\_  
 Size \_\_\_\_\_ Material \_\_\_\_\_  
 Weight/Schedule \_\_\_\_\_

**Gravel Pack**

From \_\_\_\_\_ To \_\_\_\_\_

From \_\_\_\_\_ To \_\_\_\_\_

From \_\_\_\_\_ To \_\_\_\_\_

**Hole size**

7 1/2" From 0 to 270 ft.

\_\_\_\_\_ " from \_\_\_\_\_ to \_\_\_\_\_ ft.

\_\_\_\_\_ " from \_\_\_\_\_ to \_\_\_\_\_ ft.

From 0 To 50'  
 Bore Hole Size 7 3/8" 12/10/01  
 Type Bentonite  
 Method Pressure Drilling

From \_\_\_\_\_ To \_\_\_\_\_  
 Bore Hole Size \_\_\_\_\_  
 Type \_\_\_\_\_  
 Method \_\_\_\_\_

From \_\_\_\_\_ To \_\_\_\_\_  
 Bore Hole Size \_\_\_\_\_  
 Type \_\_\_\_\_  
 Method \_\_\_\_\_

**Water Zones or Screened Intervals**

From 240 To 260  
 Mesh Size 20 Diam 4" (P.V.C.)  
 From \_\_\_\_\_ To \_\_\_\_\_  
 Mesh Size \_\_\_\_\_ Diam \_\_\_\_\_

From 240 To 260  
 Mesh Size \_\_\_\_\_ Diam \_\_\_\_\_  
 From \_\_\_\_\_ To \_\_\_\_\_  
 Mesh Size \_\_\_\_\_ Diam \_\_\_\_\_

From \_\_\_\_\_ To \_\_\_\_\_  
 Mesh Size \_\_\_\_\_ Diam \_\_\_\_\_  
 From \_\_\_\_\_ To \_\_\_\_\_  
 Mesh Size \_\_\_\_\_ Diam \_\_\_\_\_

**\* Use Data \***

Private Well: Domestic  Agricultural \_\_\_\_\_ Industrial \_\_\_\_\_ Monitoring \_\_\_\_\_  
 Public Well: Community \_\_\_\_\_ Non Community \_\_\_\_\_

**\* Abandonment Information \***

**Bored or Dig Wells**

Casing Removed, Y or N? \_\_\_\_\_  
 If Y, Depth to which casing was removed: \_\_\_\_\_  
 Depth and Type of Fill: \_\_\_\_\_  
 Source of Fill: \_\_\_\_\_  
 Bentonite Plugs: From \_\_\_\_\_ to \_\_\_\_\_ From \_\_\_\_\_ to \_\_\_\_\_

**Wells other than Bored Wells**

Casing removed, Y or N? \_\_\_\_\_  
 Depth to which casing was removed: \_\_\_\_\_  
 Applicable, depth(s), and type of gravel/sand fill: \_\_\_\_\_  
 Source of gravel or sand: \_\_\_\_\_  
 Cement: From \_\_\_\_\_ to \_\_\_\_\_ From \_\_\_\_\_ to \_\_\_\_\_


Method of permanently marking location: \_\_\_\_\_  
 Installed watertight top  
 Suggest setting pump @ approx. 200 ft.

Res. William "Rox" Bryant  
 30 Lorenzo Drive  
 Stafford  
 off 218 & Cassara Rd

• Drillers Log •

Depth	Description of Formation or Sediment	Remarks
0	15	Red Sandy Clay
15	30	Tan Clay
30	65	Grey Clay
65	75	Sand & Gravel
75	100	Brown Clay
100	205	Black Sand & Shells
205	220	Grey Clay
220	225	Sandy Clay
225	260	Sand
260	270	Grey clay

DIAGRAM  
(NOT TO SCALE)

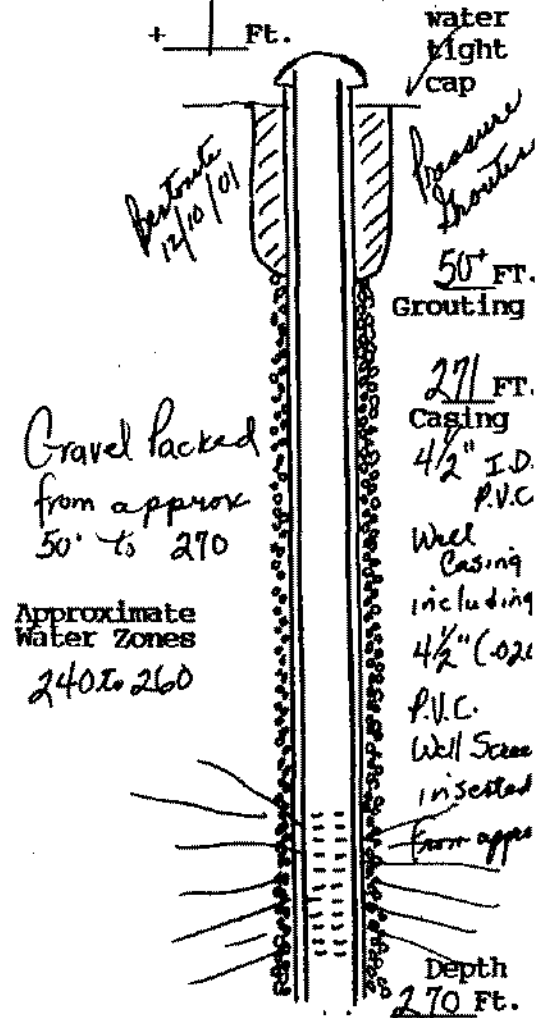

(User additional Sheets if necessary)

I certify that the information contained here is true and that this well was installed and constructed in accordance with the permit and further that the well complies with all applicable state and local regulations, ordinances and laws.

Name JOHN L. DANIELSON, JR., INC.  
 Address 4616 HOOD DRIVE  
FREDERICKSBURG, VIRGINIA 22408  
 Phone 540 (703) 898-6025 / 898-9355  
 Drillers Signature John L. Danielson, Inc.  
 Date 12/10/01 Representing JOHN L. DANIELSON, JR., INC.  
 Virginia Contractors Licence Number CLASS A 2701 014081A H/II WWC

