

Owner Michael & Darlene Courtney
 Address 202 Prescott Avenue
Manassas, Va.
 Phone 369-
 Location Behind Mother's house - 83 Berry Road

Tax Map ID 59-67
 VDH Permit WS-91-151
 VWCB Permit _____
 VWCB ID _____
 County Stafford

8/24/92 Rob Hunter
7/27/91 Paul Phelps

* Well Data *

General Information
 Drilling Method Art/Mud Rotary
 Depth to Bedrock _____
 Static Water Level 80
 Well Disinfected (Y or N) _____

Date Completed 8/21/92
 Yield 30 (GPM)
 Stabilized Water Level _____
 Disinfectant Used _____

Total Depth of Well 249
 Length of Test 1 Hr
 Natural Flow (Rate) 30 GPM
 Amount Used _____

Casing From +1' To 220'
 Size 4 1/2 Material PVC
 Weight/Schedule SDR 17

From 240' To 249'
 Size 4 1/2 Material PVC
 Weight/Schedule SDR 17

From _____ To _____
 Size _____ Material _____
 Weight/Schedule _____

Gravel Pack From 50' To 249'

From _____ To _____

From _____ To _____

Hole size 7 1/8" from 0 to 249 ft.

" from _____ to _____ ft.

" from _____ to _____ ft.

Grout From 0 To 50'

From _____ To _____

From _____ To _____

Bore Hole Size 7 1/8"
 Type Bentonite
 Method Pressure Grouting

Bore Hole Size _____
 Type _____
 Method _____

Bore Hole Size _____
 Type _____
 Method _____

Water Zones or Screened Intervals
 From 220 To 240
 Mesh Size .020 Diam 4 1/2
 From _____ To _____
 Mesh Size _____ Diam _____

Water Zone
 From 225' To 235'
 Mesh Size _____ Diam _____
 From _____ To _____
 Mesh Size _____ Diam _____

From _____ To _____
 Mesh Size _____ Diam _____
 From _____ To _____
 Mesh Size _____ Diam _____

* Use Data *

Private Well: Domestic
 Public Well: Community _____

Agricultural _____ Industrial _____ Monitoring _____
 Non Community _____

8/24/92
3/11/92 106 PM Counts
Submersible @ 140'

* Abandonment Information *

Bored or Dug Wells
 Casing Removed, Y or N? _____
 If Y, Depth to which casing was removed: _____
 Depth and Type of Fill: _____
 Source of Fill _____
 Bentonite Plugs: From _____ to _____ From _____ to _____


Wells other than Bored Wells
 Casing removed, Y or N? _____
 Depth to which casing was removed: _____
 Applicable, depth(s), and type of gravel/sand fill: _____
 Source of gravel or sand: _____
 Cement: From _____ to _____ From _____ to _____

Method of permanently marking location:
 Installed watertight top
 Suggest setting pump @ approx. 140 ft.

Well purged 12 - to 15 @ 4 PM @ 140 FT on 8/2/92

P-920547

| Depth | Description of Formation or Sediment |
|-------|--------------------------------------|
| 0 | 10 Red Clay |
| 10 | 20 Yellow Sand |
| 20 | 35 Blue Marl |
| 35 | 70 Sand & Gravel |
| 70 | 130 Black Sand |
| 130 | 170 Blue Clay |
| 170 | 225 Sandstone |
| 225 | 235 Grey sand - water zone |
| 235 | 240 Sandstone |
| 240 | 249 Blue Clay |

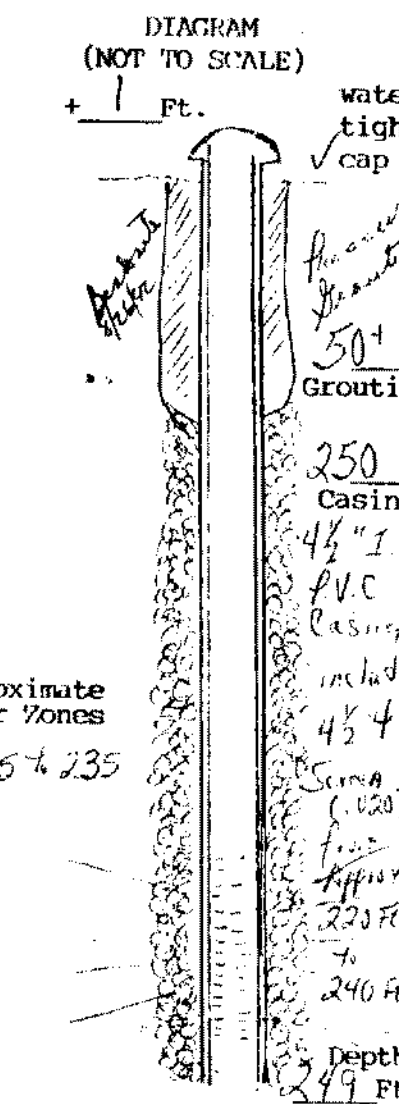

(User additional Sheets if necessary)

I certify that the information contained here is true and that this well was installed and constructed in accordance with the permit and further that the well complies with all applicable state and local regulations, ordinances and laws.

Name JOHN L. DANIELSON, JR., INC.
 Address 4616 HOOD DRIVE
FREDERICKSBURG, VIRGINIA 22408
 Phone (703) 898-6025 / 898-9355

Drillers Signature [Signature]
 Date 8/26/92 Representing JOHN L. DANIELSON, JR., INC.

Virginia Contractors License Number _____