


COMMONWEALTH OF VIRGINIA
WATER WELL COMPLETION REPORT

BWCM No. _____

(Certification of Completion/County Permit)

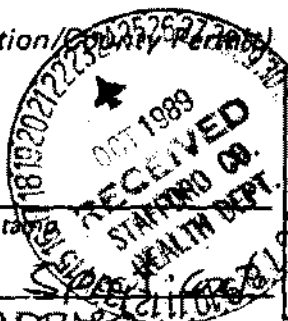

State Water Control Board
P. O. Box 11143
2111 North Hamilton St.
Richmond, Va. 23230

County/City Stafford

County/City State _____

SWCB Permit _____
County Permit _____

Certification of inspecting official:
This well does _____ does not _____
meet code/low requirements.

Date _____
For Office Use

56-64D

Tax Map I.D. No. 189 88 497
Subdivision _____
Section _____
Block _____
Lot _____
Class Well: I _____ IIA _____
IIB IIA _____ IIB _____
IIIC _____ IIID _____ IIIE _____

• Virginia Plane Coordinates
_____ N
_____ E
Latitude & Longitude
_____ N
_____ W
• Topo. Map No. _____
• Elevation _____ ft.
• Formation _____
• Lithology _____
• River Basin _____
• Province _____
• Type Logs Driller
• Cuttings no
• Water Analysis _____
• Aquifer Test _____

• Owner Construction
• Well Designation or Number Jeff 6 rows
Address _____
Phone _____

• Drilling Contractor
KING GEORGE DRILLING SERVICES, INC.
Address RT. 1 BOX 117
COLONIAL BEACH, VA. 22445
Phone _____

WELL LOCATION: 6/10 feet/miles 1/10 direction of Rt 603
and 50 feet/miles East (direction) of Rt 604
(If possible please include map showing location marked)

Date started 8-15-89 • Date completed 8-16-89 Type rig Rotary

I. WELL DATA: New Reworked _____ Deepened _____

• Total depth 240 ft.
• Depth to bedrock _____ ft.

• Hole size (Also include reamed zones)
• 8 3/4 inches from 0 to 50 ft.
• 7 inches from 50 to 212 ft.
• 3 7/8 inches from 212 to 240 ft.

• Casing size (I.D.) and material
• 1 1/2 inches from 1 to 212 ft.
Material PVC
Wt. per foot _____ or wall thickness Sch 40 in.
• 2 inches from 208 to 230 ft.
Material galv.
Wt. per foot _____ or wall thickness Sch 40 in.
• _____ inches from _____ to _____ ft.
Material _____
Wt. per foot _____ or wall thickness _____ in.

• Screen size and mesh for each zone (where applicable)
• 2 inches from 230 to 240 ft.
• Mesh size 16 Type Johnson S. Steel
• _____ inches from _____ to _____ ft.
• Mesh size _____ Type _____
• _____ inches from _____ to _____ ft.
• Mesh size _____ Type _____
• _____ inches from _____ to _____ ft.
• Mesh size _____ Type _____

• Gravel pack
• From X to _____ ft.
• From _____ to _____ ft.

• Grout
• From 0 to 50 ft., Type Cement
• From _____ to _____ ft., Type _____

2. WATER DATA • Water temperature _____

• Static water level (unpumped level-measured) 130
• Stabilized measured pumping water level 165
• Stabilized yield 20 gpm after 4 hou
Natural Flow: Yes _____ No _____ flow rate: _____ g p
Comment on quality iron

3. WATER ZONES: From 213 To 240
From _____ To _____ From _____ To _____
From _____ To _____ From _____ To _____

4. USE DATA:
Type of use: Drinking Livestock Watering _____
Irrigation _____ Food processing _____ Household
Manufacturing _____ Fire safety _____ Cleaning _____
Recreation _____ Aesthetic _____ Cooling or heating _____
Injection _____ Other _____

• Type of facility: Domestic Public water supply _____
Public institution _____ Farm _____ Industry _____
Commercial _____ Other _____

5. PUMP DATA: Type _____ Rated H.P. _____
• Intake depth _____ Capacity _____ at _____ head

6. WELLHEAD: Typc well seal
Pressure tank _____ gal. Loc. _____
Sample tap _____ Measurement port _____
Well vent _____ Pressure tank valve _____
Gate valve _____ Check valve (when required) _____
Electrical disconnect switch on power supply _____

7. DISINFECTION: Well disinfected _____ yes _____ no _____
Date _____ Disinfectant used _____
Amount _____ Hours used _____

8. ABANDONMENT (where applicable) • yes _____ no _____
Casing pulled yes _____ no not applicable _____
Plugging grout From _____ to _____ material _____

9. State law requires submitting to the Virginia State Water Control Board information about groundwater and wells for every well made in the State intended for water, or any other non-exempt well. This information must be submitted whether the well is completed, on standby, or abandoned. Information required includes: an accurately and completely prepared water well completion report, full data from any aquifer pumping tests, drill cuttings taken at ten foot intervals (unless exemption is secured), the results of any chemical analyses, and copies of any geophysical logs. Quarterly pumpage and use reports are required from owners of public supply and industrial wells. County or State permits to drill may be required in some parts of the state. Some counties require submission of a water well completion report. The Virginia State Health Department requires a water well completion report for public supply wells.

10. DRILLERS LOG (use additional Sheets if necessary)			REMARKS (water, caving, cavities, broken, core, shot, etc.)	11. Drilling Time (Min.)	12. DIAGRAM OF WELL CONSTRUCTION (with dimensions)
DEPTH (feet)		TYPE OF ROCK OR SOIL (color, material, fossils, hardness, etc.)			
From	To				
0	40	Brown white + yellow sand			
40	60	green sand			
60	80	grey + black sand			
80	100	grey + pink clay			
100	203	Black sand + shells			
203	240	white + grey sand			

13. Well lot dedicated? _____; Size _____ ft. X _____ ft.; Well house? _____
 Distance to nearest pollutant source _____ ft., Type _____
 Distance to nearest property line _____ ft., Building _____ ft.

14. WATER SERVICE PIPE: Checked under _____ p.s.i. for _____ minutes. Pipe size _____ inches, Material _____
 Installer _____
 Date _____

15. I certify that the information contained herein is true and correct and that this well and/or system has been installed and constructed in accordance with the requirements for well construction as specified in compliance with appropriate county or independent city ordinances and the laws and rules of the Commonwealth of Virginia.

State Water Control Board Regional Offices

Valley Reg. Off.
 116 North Main Street
 P. O. Box 268
 Bridgewater, Va. 22812
 803-828-2595

Piedmont Reg. Off.
 4010 West Broad Street
 P. O. Box 6616
 Richmond, Va. 23230
 804-257-1006

Southwest Reg. Off.
 18 East Main Street
 P. O. Box 476
 Longdon, Va. 24210
 628-5183

Tidewater Reg. Off.
 287 Pembroke Office Park
 Suite 310 Pembroke No. 2
 Va. Beach, Va. 23462
 804-499-8742

Central Reg. Off.
 Olive Park
 Peters Creek Road
 Lake, Va. 24019
 982-7432

Northern Virginia Reg. Off.
 5515 Cherokee Avenue
 Suite 404
 Alexandria, Va. 22312
 703-750-9111

Signature C. E. Keating (Seal), Date 8-16-89
 (Well driller or authorized person)
 License No. VA-023065
MWO-299