

**Commonwealth of Virginia
Uniform Water Well Completion Report**

Permit issued to:

Owner: Charles Jires
 Address: 950 White Oak Rd
Dalrymple, Va. 22405
 Phone: 373-5328
 Location: 218 -> Bethel Church Rd -> Davis home / road to Leonard Giovedano

Tax Map ID: 51-147-4
 VDH Permit: 189-37-45
 WWCB Permit: _____
 WWCB ID: _____
 County: Stafford
1/2/01 Michael Newman

Well Classification: IIIA _____ IIIB IIIC _____ IV _____
 * Well Data *

General Information

Drilling Method: Air Rotary
 Depth to Bedrock: _____
 Static Water Level: 20
 Well Disinfected (Y or N): _____

Date Completed: 7/27/93
 Yield: 60 (GPM)
 Stabilized Water Level: 80
 Disinfectant Used: _____

Total Depth of Well: 150
 Length of Test: 4 hrs
 Natural Flow (Rate): _____
 Amount Used: _____

Casing

From: 4 1/2" To: 130
 Size: 4 1/2" Material: P.V.C.
 Weight/Schedule: SDR 17

From: _____ To: _____
 Size: _____ Material: _____
 Weight/Schedule: _____

From: _____ To: _____
 Size: _____ Material: _____
 Weight/Schedule: _____

Gravel Pack

From: 50 To: 150

From: _____ To: _____

From: _____ To: _____

Hole size

7 7/8" from 0 to 150 ft.

_____ " from _____ to _____ ft.

_____ " from _____ to _____ ft.

Grout

From: 0 To: 50'
 Bore Hole Size: 7 7/8"
 Type: Bentonite
 Method: pressure pack

From: _____ To: _____
 Bore Hole Size: _____
 Type: _____
 Method: _____

From: _____ To: _____
 Bore Hole Size: _____
 Type: _____
 Method: _____

Water Zones or Screened Intervals

From: 130 To: 150
 Mesh Size: .020 Diam: 4 1/2" (P.V.C.)
 From: _____ To: _____
 Mesh Size: _____ Diam: _____

approx water zone
 From: 135 To: 148
 Mesh Size: _____ Diam: _____
 From: _____ To: _____
 Mesh Size: _____ Diam: _____

From: _____ To: _____
 Mesh Size: _____ Diam: _____
 From: _____ To: _____
 Mesh Size: _____ Diam: _____

*** Use Data ***

Private Well: Domestic Agricultural _____ Industrial _____ Monitoring _____
 Public Well: Community _____ Non Community _____

*** Abandonment Information ***

Bored or Dug Wells

Casing Removed, Y or N?: _____
 If Y, Depth to which casing was removed: _____
 Depth and Type of Fill: _____
 Source of Fill: _____
 Bentonite Plugs: From _____ to _____ From _____ to _____

Wells other than Bored Wells

Casing removed, Y or N?: _____
 Depth to which casing was removed: _____
 Applicable, depth(s), and type of gravel/sand fill: _____
 Source of gravel or sand: _____
 Cement: From _____ to _____ From _____ to _____

Method of permanently marking location: _____
 Installed watertight top
 Suggest setting pump @ approx. 100 ft.
Well pumped 20 GPM @ 100 ft.

Charles Jones
"Doris Lane"


Stafford off 218 1/2 Bethel Church Rd
Next to Leonardo Gardens
 Drillers Log

ADVANCE

Depth	Description of Formation or Sediment	Remarks
0	5	fill
5	30	Blue Marl
30	110	Black Sand
110	120	Grey Clay
120	135	Sandy Grey Clay
135	148	Grey Sand & Sandstone
148	150	Grey clay

4 1/2"

DIAGRAM
 (NOT TO SCALE)

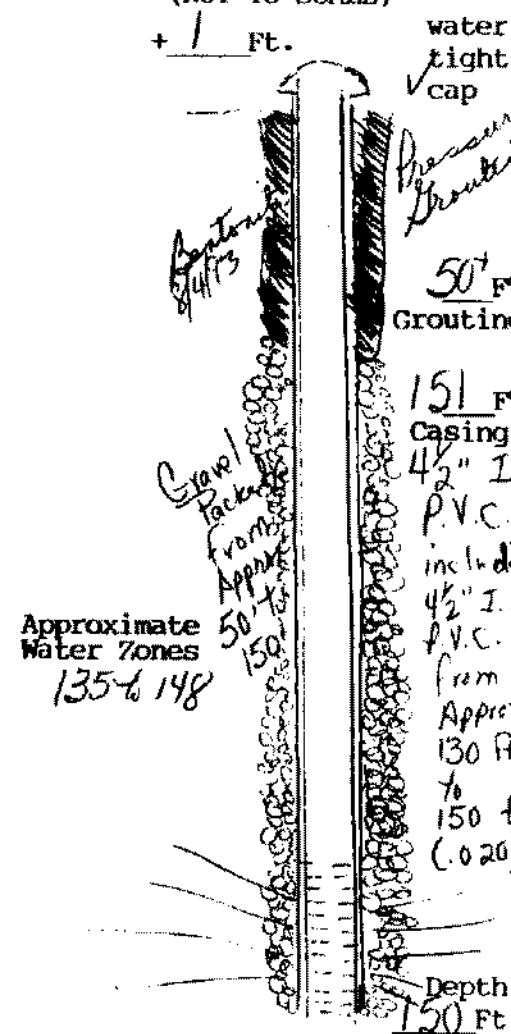

(User additional Sheets if necessary)

I certify that the information contained here is true and that this well was installed and constructed in accordance with the permit and further that the well complies with all applicable state and local regulations, ordinances and laws.

Name JOHN L. DANIELSON, JR., INC.
 Address 4616 HOOD DRIVE
FREDERICKSBURG, VIRGINIA 22408
 Phone (703) 898-6025 / 898-9355

Drillers Signature [Signature]
 Date 9/1/93 representing JOHN L. DANIELSON, JR., INC.

Virginia Contractors License Number CLASS A 2701 014084A H/H WWC