

Commonwealth of Virginia
 22406 Uniform Water Well Completion Report

Log Home
Recreational Lane
Underwoodburg 22406
 752-4413
 Owner Sophia P. Latta
 Address 180 Bethel Church Rd.
 Phone 371-4247
 Location #600- 5th Drive on Right

Tax Map ID 56-119A
 VDH Permit SWP-94-441
 WVCB Permit _____
 WVCB ID _____
 County STAFFORD
11/29/95 Rob Snyder

Well Classification IIIA _____ IIIB IIIC _____ IV _____
 * Well Data *

General Information
 Drilling Method Chis Rotary
 Depth to Bedrock _____
 Static Water Level approx 100'
 Well Disinfected (Y or N) _____

Date Completed 2/10/95
 Yield 25 (GPM)
 Stabilized Water Level _____
 Disinfectant Used _____

Total Depth of Well 240'
 Length of Test approx 1 Hr.
 Natural Flow (Rate) _____
 Amount Used _____

Casing
 From +1 To 99
 Size 6 3/4 Material P.V.C.
 Weight/Schedule SDR 27

From 94 To 215
 Size 4" Material P.V.C.
 Weight/Schedule Sch. 40

From 235 To 240
 Size 4" Material P.V.C.
 Weight/Schedule Sch 40

Gravel Pack
 From _____ To _____
 Hole size _____
 Grout _____
 From 0 To 50' 2/10/95
 Bore Hole Size 10
 Type Bentonite
 Method Pressure Grouting

From _____ To _____
 Hole size 7 1/8" from 60 to 99 ft.
 Bore Hole Size _____
 Type _____
 Method _____

From _____ To _____
 Hole size 6 1/8" from 99 to 240 ft.
 Bore Hole Size _____
 Type _____
 Method _____

Water Zones or Screened Intervals
 From 215 To 235
 Mesh Size .020 Diam 7" (P.V.C.)
 From _____ To _____
 Mesh Size _____ Diam _____

approx water zone
 From 210 To 230
 Mesh Size _____ Diam _____
 From _____ To _____
 Mesh Size _____ Diam _____

From _____ To _____
 Mesh Size _____ Diam _____
 From _____ To _____
 Mesh Size _____ Diam _____

* Use Data *

Private Well: Domestic Agricultural _____ Industrial _____ Monitoring _____
 Public Well: Community _____ Non Community _____

* Abandonment Information *

Bored or Dug Wells
 Casing Removed, Y or N? _____
 Y, Depth to which casing was removed: _____
 Depth and Type of Fill: _____
 Source of Fill _____
 Cement Plugs: From _____ to _____ From _____ to _____



Wells other than Bored Wells
 Casing removed, Y or N? _____
 Depth to which casing was removed: _____
 Applicable, depth(s), and type of gravel/sand fill: _____
 Source of gravel or sand: _____
 Cement: From _____ to _____ From _____ to _____

Method of permanently marking location: _____
 Installed watertight top _____
 Setting pump @ approx. 180 ft. (Well pumped 15 G.P.M. @ 180' on 2/10/95)
P.V.C. casing @ approx. 95'
Wrenches & torque arrestors out of 4" casing.

Althaus / Family Log Homes
Sopie Patta - Stafford #600 off 218
Bethel Church Rd / 5th Driveway on Right

* Drillers Log *

Depth	Description of Formation or Sediment	Remarks
0	10	Sandy Red Clay
10	40	Yellow Sand
40	70	Blue Marl
70	95	Black Sand
95	120	Blue Clay
120	195	Black Sand
195	210	Blue Clay
210	230	Grey Sand
230	240	Brown Clay

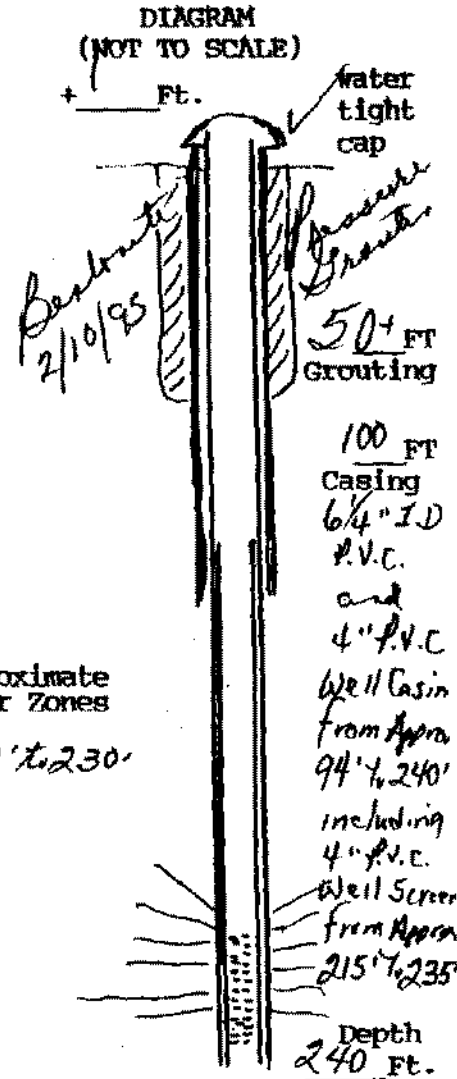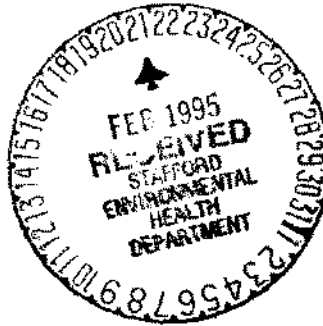

(User additional Sheets if necessary)

I certify that the information contained here is true and that this well was installed and constructed in accordance with the permit and further that the well complies with all applicable state and local regulations, ordinances and laws.

Name JOHN L. DANIELSON, JR., INC.
 Address 4616 HOOD DRIVE
FREDERICKSBURG, VIRGINIA 22408
 Phone (703) 898-6025 / 898-9355

Drillers Signature [Signature]
 Date 2/10/95 Representing JOHN L. DANIELSON, JR., INC.

Virginia Contractors License Number CLASS A 2701 014084A H/II WVC