

**Commonwealth of Virginia
Uniform Water Well Completion Report**

Sullivan
White Oak Road
Fredericksburg, Va. 22405
373-0840 FAX 373-5810

Owner Russell G Sullivan
 Address 66 White Oak Road
Fredericksburg, Va. 22405
 Phone 373-0840
 Location Chapel Greens Acres # 4 1145 Chapel Green Road
(202 77 211)

Tax Map ID 56-63-4
 VDH Permit SWP-96-144
 VWCB Permit _____
 VWCB ID _____
 County Stafford
4/13/96 Rob Snydeman
SFF

Well Classification IIIA _____ IIIB IIIC _____ IV _____
 * Well Data *

General Information

Drilling Method Mud Rotary
 Depth to Bedrock _____
 Static Water Level 80
 Well Disinfected (Y or N) _____

Date Completed 2/24/97
 Yield 25 (GPM)
 Stabilized Water Level 200'
 Disinfectant Used _____

Total Depth of Well 339
 Length of Test approx
 Natural Flow (Rate) _____
 Amount Used _____

Casing

From 4 1/2 To 300
 Size 4 1/2 Material P.V.C.
 Weight/Schedule S.D.R 17

From 320 To 339
 Size 4 1/2 Material P.V.C.
 Weight/Schedule S.D.R 17

From _____ To _____
 Size _____ Material _____
 Weight/Schedule _____

Gravel Pack

From _____ To _____

From _____ To _____

From _____ To _____

Hole size

7 1/2" from 0 to 339 ft.

_____ " from _____ to _____ ft.

_____ " from _____ to _____ ft.

Grout

From 0 To 70'
 Bore Hole Size 7 1/2"
 Type Bentonite
 Method Pressure Grouting

From _____ To _____
 Bore Hole Size _____
 Type _____
 Method _____

From _____ To _____
 Bore Hole Size _____
 Type _____
 Method _____

Water Zones or Screened Intervals

From 300 To 320
 Mesh Size 016 Diam 4 1/2" (P.V.C.)
 From _____ To _____
 Mesh Size _____ Diam _____

approx water zone
 From 300 To 320'
 Mesh Size _____ Diam _____
 From _____ To _____
 Mesh Size _____ Diam _____

From _____ To _____
 Mesh Size _____ Diam _____
 From _____ To _____
 Mesh Size _____ Diam _____

*** Use Data ***

Private Well: Domestic Agricultural _____ Industrial _____ Monitoring _____
 Public Well: Community _____ Non Community _____

*** Abandonment Information ***

Bored or Dug Wells

Casing Removed, Y or N? _____
 If Y, Depth to which casing was removed: _____
 Depth and Type of Fill: _____
 Source of Fill _____
 Bentonite Plugs: From _____ to _____ From _____ to _____

Wells other than Bored Wells

Casing removed, Y or N? _____
 Depth to which casing was removed: _____
 Applicable, depth(s), and type of gravel/sand fill: _____
 Source of gravel or sand: _____
 Cement: From _____ to _____ From _____ to _____

Method of permanently marking location:

Installed watertight top
 Suggest setting pump @ approx. 220 ft.
Well pumped 15 G.P.M. @ 220' on 2/24/97

Russell Sullivan
Chapel Green Acres #4
Stafford
45 Chapel Green Rd


(202-411-218)

Drillers Log

Depth	Description of Formation or Sediment	Remarks
0	10	Heavy Red Clay
10	40	Sand & Gravel
40	100	Blue Marl
100	200	Black Sand
200	300	Red Clay
300	320	Grey Sand - water zone
320	399	Brown Clay



(User additional Sheets if necessary)

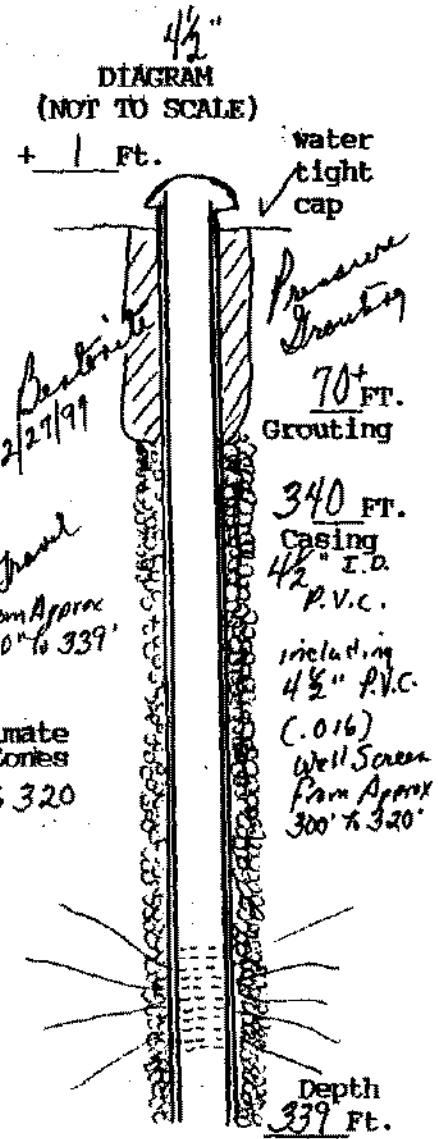

I certify that the information contained here is true and that this well was installed and constructed in accordance with the permit and further that the well complies with all applicable state and local regulations, ordinances and laws.

Name JOHN L. DANIELSON, JR., INC.
 Address 4616 HOOD DRIVE
FREDERICKSBURG, VIRGINIA 22408
 Phone 540 (703) 898-6025 / 898-9355

Drillers Signature Russell Danielson, Pres.
 Date 2/27/97 Representing JOHN L. DANIELSON, JR., INC.

Virginia Contractors License Number CLASS A 2701 0140B4A H/H WWC