

**Commonwealth of Virginia
Uniform Water Well Completion Report**

Newton
371-0871
371-2694
752-0804

Owner Justin Scott Newton
 Address 296 Selwynton
Fredricksburg Va. 22405
 Phone 371-0871
 Location 218 → 210 #604 → #603 / Selwynton
Lot @ R. C. French Lane

Well Classification IIIA IIIB ✓ IIIC IV

Tax Map ID 56-76A
 VDH Permit SWP-97-161
 VWCB Permit _____
 VWCB ID _____
 County Stafford
5/20/99 Daniel Gerschyn
G.R.G.

* Well Data *

General Information

Drilling Method Air Mud Rotary Date Completed 9/10/97 Total Depth of Well 287
 Depth to Bedrock _____ Yield 10 (GPM) Length of Test approx 9 Hrs.
 Static Water Level approx 190 Stabilized Water Level 210 Natural Flow (Rate) _____
 Well Disinfected (Y or N) _____ Disinfectant Used _____ Amount Used _____

Casing

From 41 To 262 From 282 To 287 From _____ To _____
 Size 4 1/2" Material P.V.C. Size 4 1/2" Material P.V.C. Size _____ Material _____
 Weight/Schedule SDR 17 Weight/Schedule SDR 17 Weight/Schedule _____

Gravel Pack

From 115' To 287' From _____ To _____ From _____ To _____

Hole size

8" from 0 to 287' " from _____ to _____ ft. " from _____ to _____ ft.

Grout

From 0 To 115' From _____ To _____ From _____ To _____
 Bore Hole Size 8" Bore Hole Size _____ Bore Hole Size _____
 Type Bentonite Type _____ Type _____
 Method Pressure Grouting Method _____ Method _____

Water Zones or Screened Intervals

From 262 To 282 From approx water zone 262 To 282 From _____ To _____
 Mesh Size .020 Diam 4 1/2" (P.V.C.) Mesh Size _____ Diam _____ Mesh Size _____ Diam _____
 From _____ To _____ From _____ To _____ From _____ To _____
 Mesh Size _____ Diam _____ Mesh Size _____ Diam _____ Mesh Size _____ Diam _____

* Use Data *

Private Well: Domestic Agricultural _____ Industrial _____ Monitoring _____
 Public Well: Community _____ Non Community _____

* Abandonment Information *

Bored or Dug Wells

Casing Removed, Y or N?: _____
 If Y, Depth to which casing was removed: _____
 Depth and Type of Fill: _____
 Source of Fill _____
 Bentonite Plugs: From _____ to _____ From _____ to _____

Wells other than Bored Wells

Casing removed, Y or N? _____
 Depth to which casing was removed: _____
 Applicable, depth(s), and type of gravel/sand fill: _____
 Source of gravel or sand: _____
 Cement: From _____ to _____ From _____ to _____


Method of permanently marking location: _____
 Installed watertight top
 suggest setting pump @ approx. 250' ft.

Virginia State Department of Professional Occupations

Jason Newton
 Jason Scott Newton
 Clifford

218 → 604 → 603 (Salvatore Rd)
 Lot on Right @ Power Lines
 * Drillers Log *

Depth	Description of Formation or Sediment	Remarks
0	10	Red Clay
10	20	Yellow Sand
20	90	Blue Marl
90	190	Black Sand
190	230	Blue Clay
230	282	Grey Sand
282	287	Brown Clay

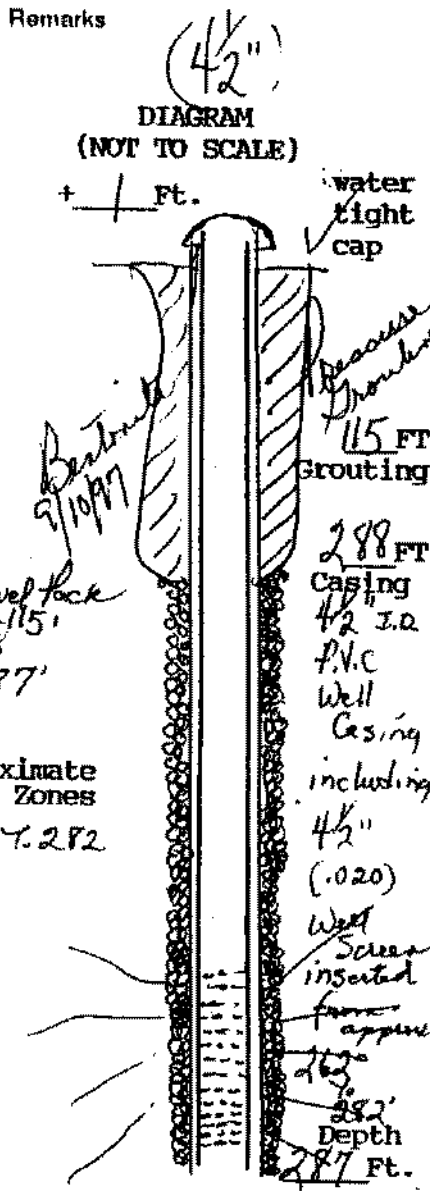

Gravel pack from 15' to 287'
 Approximate Water Zones 262-282

(User additional Sheets if necessary)

I certify that the information contained here is true and that this well was installed and constructed in accordance with the permit and further that the well complies with all applicable state and local regulations, ordinances and laws.

Name JOHN L. DANIELSON, JR., INC.
 Address 4616 HOOD DRIVE
FREDERICKSBURG, VIRGINIA 22408
 Phone 590 (288) 898-6025 / 898-9355

Drillers Signature Jason L. Danielson, Inc.
 Date 9/10/97 Representing JOHN L. DANIELSON, JR., INC.

Virginia Contractors License Number CLASS A 2701 014084A H/H WWC