

**Commonwealth of Virginia
Uniform Water Well Completion Report**

AJDLOD CLIFT
P.O. Box 652
King George, VA 22485
 Phone _____
 Location Rte. 218

Tax Map ID 56-113 B (part of)
 VDH Permit WS-91-147
 VWCB Permit _____
 VWCB ID _____
 County Stafford

* Well Data *

General Information

Drilling Method <u>Kotary</u>	Date Completed <u>9-24-92</u>	Total Depth of Well <u>350 FT.</u>
Depth to Bedrock _____	Yield <u>30</u> (GPM)	Length of Test <u>4 hrs.</u>
Static Water Level <u>100</u>	Stabilized Water Level <u>128</u>	Natural Flow (Rate) _____
Well Disinfected (Y or N) <u>Y</u>	Disinfectant Used <u>chlorine</u>	Amount Used <u>50 P/M</u>

Casing

From <u>+1</u> To <u>190</u>	From <u>190</u> To <u>340</u>	From _____ To _____
Size <u>4 1/2"</u> Material <u>PVC</u>	Size <u>2"</u> Material <u>Galvanized</u>	Size _____ Material _____
Weight/Schedule <u>40</u>	Weight/Schedule <u>42</u>	Weight/Schedule _____

Gravel Pack

From _____ To _____ From _____ To _____ From _____ To _____

Grout

From <u>0</u> To <u>80</u>	From <u>80</u> To <u>190</u>	From <u>190</u> To <u>350</u>
Bore Hole Size <u>8"</u>	Bore Hole Size <u>7"</u>	Bore Hole Size <u>3 1/8"</u>
Type <u>Bentonite Clay</u>	Type _____	Type _____
Method <u>Pressure</u>	Method _____	Method _____

Water Zones or Screened Intervals

From <u>340</u> To <u>350</u>	From _____ To _____	From _____ To _____
Mesh Size <u>10</u> Diam <u>2"</u>	Mesh Size _____ Diam _____	Mesh Size _____ Diam _____
From _____ To _____	From _____ To _____	From _____ To _____
Mesh Size _____ Diam _____	Mesh Size _____ Diam _____	Mesh Size _____ Diam _____

* Use Data *

Private Well: Domestic Agricultural _____ Industrial _____ Monitoring _____
 Public Well: Community _____ Non Community _____

* Abandonment Information *

Bored or Dug Wells

Casing Removed, Y or N? _____
 If Y, Depth to which casing was removed: _____
 Depth and Type of Fill: _____
 Source of Fill _____
 Bentonite Plugs: From _____ to _____ From _____ to _____


Wells other than Bored Wells

Casing removed, Y or N? _____
 Depth to which casing was removed: _____
 Applicable, depth(s), and type of gravel/sand fill: _____
 Source of gravel or sand: _____
 Cement: From _____ to _____ From _____ to _____

Method of permanently marking location: _____



Depth	Description of Formation or Sediment
0 - 10	Sand
10 - 80	Green clay
80 - 165	Black sand
165 - 170	Gray clay
170 - 193	Sand
193 - 235	Gray clay
235 - 240	Red clay
240 - 300	Gray clay
300 - 330	Clay & sand
330 - 350	Blue + white sand

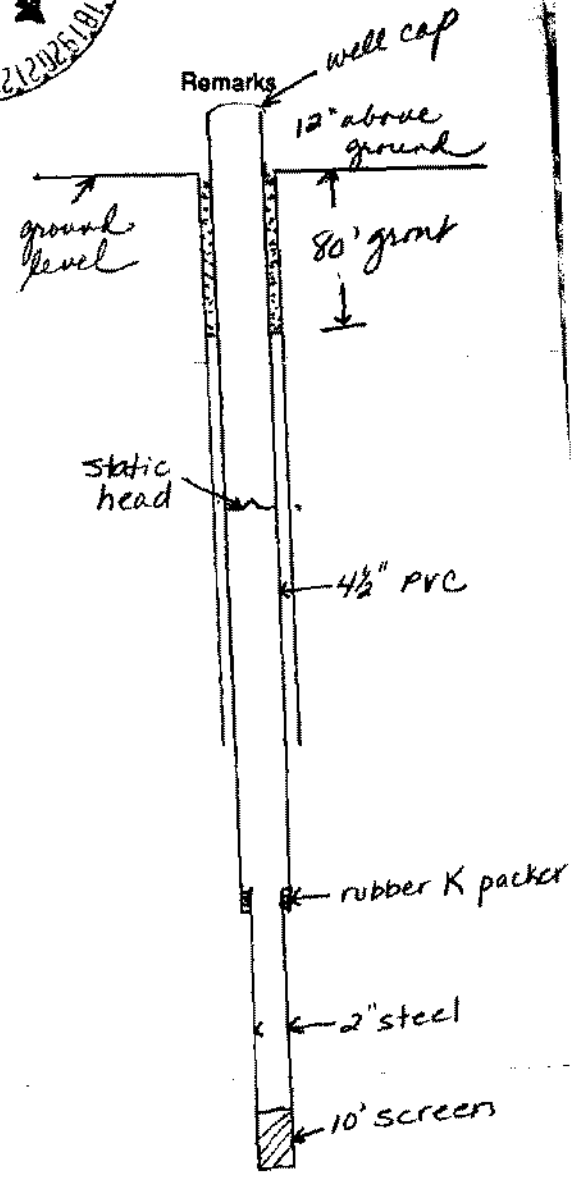

(User additional Sheets if necessary)

I certify that the information contained here is true and that this well was installed and constructed in accordance with the permit and further that the well complies with all applicable state and local regulations, ordinances and laws.

Name King George Drilling
 Address FRT 1 - Box 86K
Colonial Beach, VA 22443
 Phone (804) 224-9130

Drillers Signature Janet Anne Jordan - Shepherd
 Date 9-25-92 Representing Hennrich M. Frank, Jr.

Virginia Contractors License Number VA 023065