

Commonwealth of Virginia
Uniform Water Well Completion Report

Permit issued to:

Mark Sullivan

Tax Map ID 56-149-A1
VDH Permit WS-93-197
VWCB Permit _____
VWCB ID _____
County STAFFORD
Date 9/12/93
Radley Wright
T. E. Thompson
SFF

Location 192 Wood Landing Rd. 39 Wood Landing Rd. Fredericksburg, Va. Palmarville, Va. 22405
540-891-7449 W 703-690-0600 Fax 22405 391-6824
192 Wood Landing Rd.
Well Classification IIIA IIIB IIIC IV
Approx 1 Mile E of Jct of Loop 712 * Well Data *

General Information
Drilling Method Mod Rotary Date Completed 8/25/95 Total Depth of Well 220
Depth to Bedrock _____ Yield 25 (GPM) Length of Test approx 1 Hr.
Static Water Level 100. Stabilized Water Level 120 Natural Flow (Rate) _____
Well Disinfected (Y or N) _____ Disinfectant Used _____ Amount Used _____

Casing
From 11 To 94 From 90 To 190 From 210 To 220
Size 6 1/4 Material P.V.C. Size 4" Material P.V.C. Size 4" Material P.V.C.
Weight/Schedule SDR 27 Weight/Schedule Sch 40 Weight/Schedule Sch 40

Gravel Pack
From _____ To _____ From _____ To _____ From _____ To _____
Hole size 10" from 0 to 50ft. 7 1/8" from 50 to 94ft. 6" from 94 to 220ft.
Grout
From 0 To 50' 8/25/95 From _____ To _____ From _____ To _____
Bore Hole Size 10" Bore Hole Size _____ Bore Hole Size _____
Type Grout Type _____ Type _____
Method Pressure Grouting Method _____ Method _____

Water Zones or Screened Intervals
From 190 To 210 From 192 To 208 From _____ To _____
Mesh Size 20 Diam 4" (P.V.C.) Mesh Size _____ Diam _____ Mesh Size _____ Diam _____
From _____ To _____ From _____ To _____ From _____ To _____
Mesh Size _____ Diam _____ Mesh Size _____ Diam _____ Mesh Size _____ Diam _____

* Use Data *

Private Well: Domestic Agricultural _____ Industrial _____ Monitoring _____
Public Well: Community _____ Non Community _____

* Abandonment Information *

Bored or Dug Wells
Casing Removed, Y or N?: _____
If Y, Depth to which casing was removed: _____
Depth and Type of Fill: _____
Source of Fill: _____
Bentonite Plugs: From _____ to _____ From _____ to _____


Wells other than Bored Wells
Casing removed, Y or N? _____
Depth to which casing was removed: _____
Applicable, depth(s), and type of gravel/sand fill: _____
Source of gravel or sand: _____
Cement: From _____ to _____ From _____ to _____

Method of permanently marking location:
 Installed watertight top
Suggest setting pump @ approx. 140 ft. (well pumped 15 GPM. on 140' on 8/29/95)
you will encounter 4" casing @ approx 90 ft.
Suggest keeping centralizer & torque arrester out of 4" casing
953828

Glass Ferry
 # 712 / 1142 Wood Landing Rd.
Stafford

* Drillers Log *

Depth	Description of Formation or Sediment	Remarks
0	10	Sandy Red Clay
10	30	Yellow Sand
30	90	Blue Marl
90	140	Black Sand
140	192	Blue Clay
192	208	Grey Sand (water zone)
208	220	Brown Clay

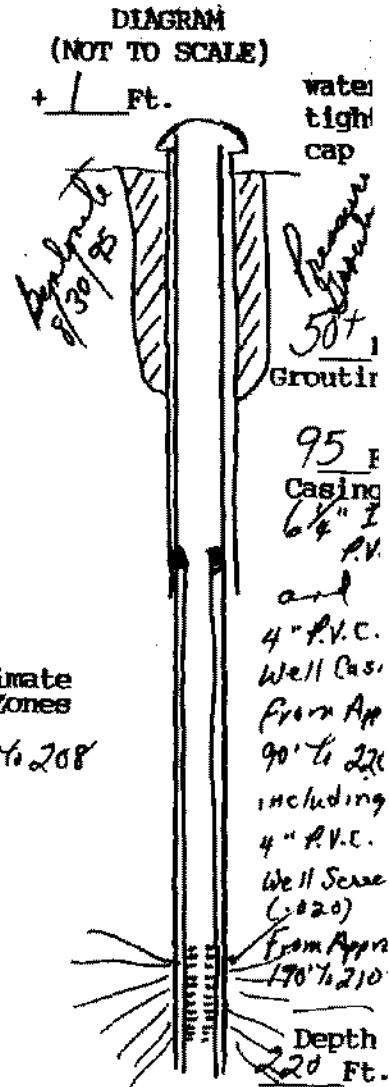

Approximate Water Zones
 192 to 208



(User additional Sheets if necessary)

I certify that the information contained here is true and that this well was installed and constructed in accordance with the permit and further that the well complies with all applicable state and local regulations, ordinances and laws.

Name JOHN L. DANIELSON, JR., INC.
 Address 4616 HOOD DRIVE
FREDERICKSBURG, VIRGINIA 22408
 Phone (703) 898-6025 / 898-9355

Drillers Signature [Signature]
 Date 8/30/85 Representing JOHN L. DANIELSON, JR., INC.

Virginia Contractors License Number CLASS A 2701 014084A II/H WWC