

White Oak Road  
Fredericksburg, VA 22405  
373-0840 Fax 303-5810  
Agri 310-5015  
Commonwealth of Virginia  
Uniform Water Well Completion Report

Owner Larry Shelling, Bunker Inc / For Sale  
Address 161 White Oak Road  
Fredericksburg Va. 22405  
Phone 373-0840  
Location #600 689 Bethel Church Road -  
2.6 Miles off 218 on Left.  
Well Classification IIIA IIIB  IIIC IV

Tax Map ID 57-9  
VDH Permit SWT-98-31  
VWCB Permit \_\_\_\_\_  
VWCB ID \_\_\_\_\_  
County Stafford  
2/3/98 Rob Sargent  
CRG

General Information  
Drilling Method Air Rotary  
Depth to Bedrock \_\_\_\_\_  
Static Water Level 80  
Well Disinfected (Y or N) \_\_\_\_\_

(4 1/2")  
Date Completed 6/5/98  
Yield 20 (GPM)  
Stabilized Water Level 116'  
Disinfectant Used \_\_\_\_\_

Total Depth of Well 166  
Length of Test Approx 3 Hrs.  
Natural Flow (Rate) \_\_\_\_\_  
Amount Used \_\_\_\_\_

Casing  
From +1 To 146  
Size 4 1/2" Material P.V.C.  
Weight/Schedule S.D.R. 17

From \_\_\_\_\_ To \_\_\_\_\_  
Size \_\_\_\_\_ Material \_\_\_\_\_  
Weight/Schedule \_\_\_\_\_

From \_\_\_\_\_ To \_\_\_\_\_  
Size \_\_\_\_\_ Material \_\_\_\_\_  
Weight/Schedule \_\_\_\_\_

Gravel Pack  
From 50 To 166

From \_\_\_\_\_ To \_\_\_\_\_

From \_\_\_\_\_ To \_\_\_\_\_

Hole size  
" from \_\_\_\_\_ to \_\_\_\_\_ ft.

" from \_\_\_\_\_ to \_\_\_\_\_ ft.

" from \_\_\_\_\_ to \_\_\_\_\_ ft.

Grout  
From 0 To 50' H. 4/8  
Bore Hole Size 1 7/8  
Type Bentonite  
Method Pressure Grouting

From \_\_\_\_\_ To \_\_\_\_\_  
Bore Hole Size \_\_\_\_\_  
Type \_\_\_\_\_  
Method \_\_\_\_\_

From \_\_\_\_\_ To \_\_\_\_\_  
Bore Hole Size \_\_\_\_\_  
Type \_\_\_\_\_  
Method \_\_\_\_\_

Water Zones or Screened Intervals  
From 146 To 166  
Mesh Size .020 Diam 4 1/2" (P.V.C.)

From 146 To 166  
Mesh Size \_\_\_\_\_ Diam \_\_\_\_\_

From \_\_\_\_\_ To \_\_\_\_\_  
Mesh Size \_\_\_\_\_ Diam \_\_\_\_\_

\* Use Data \*

Private Well: Domestic  Agricultural \_\_\_\_\_ Industrial \_\_\_\_\_ Monitoring \_\_\_\_\_  
Public Well: Community \_\_\_\_\_ Non Community \_\_\_\_\_

\* Abandonment Information \*

Bored or Dug Wells  
Casing Removed, Y or N? \_\_\_\_\_  
If Y, Depth to which casing was removed: \_\_\_\_\_  
Depth and Type of Fill: \_\_\_\_\_  
Source of Fill \_\_\_\_\_  
Bentonite Plugs: From \_\_\_\_\_ to \_\_\_\_\_ From \_\_\_\_\_ to \_\_\_\_\_


Wells other than Bored Wells  
Casing removed, Y or N? \_\_\_\_\_  
Depth to which casing was removed: \_\_\_\_\_  
Applicable, depth(s), and type of gravel/sand fill: \_\_\_\_\_  
Source of gravel or sand: \_\_\_\_\_  
Cement: From \_\_\_\_\_ to \_\_\_\_\_ From \_\_\_\_\_ to \_\_\_\_\_

Method of permanently marking location: \_\_\_\_\_  
 Installed watertight top  
Suggest setting pump @ approx. 130 ft.

Larry R. Sullivan  
 # 600 (689 Bethel Church Rd.)  
Stafford  
 approx 2.6 miles off 218 - on left  
 Drillers Log

ALBERT  
 57  
 76 #01 4124  
 15-108 02  
 15-108 02  
 15-108 02

Depth	Description of Formation or Sediment	Remarks
0	10	Red Clay
10	30	Yellow Sand
30	110	Black Sand
110	130	Grey clay
130	146	Sandy Grey Clay
146	166	Grey Sand

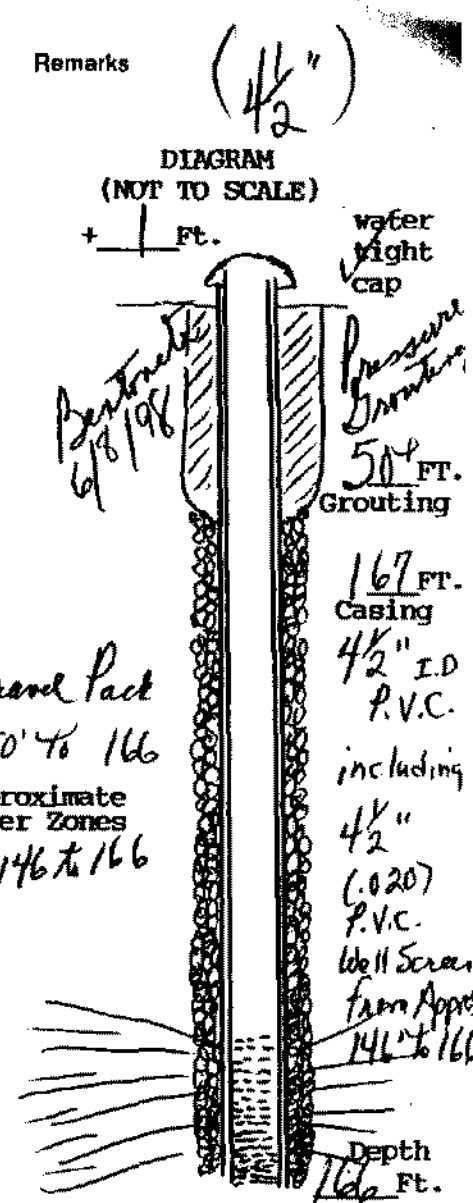

(User additional Sheets if necessary)

I certify that the information contained here is true and that this well was installed and constructed in accordance with the permit and further that the well complies with all applicable state and local regulations, ordinances and laws.

Name JOHN L. DANIELSON, JR., INC.  
 Address 4616 HOOD DRIVE  
FREDERICKSBURG, VIRGINIA 22408  
 Phone 570 (703) 898-6025 / 898-9355

Drillers Signature [Signature] Pres.  
 Date 6/8/98 Representing JOHN L. DANIELSON, JR., INC.

Virginia Contractors License Number CLASS A 2701 014084A H/H WWC