

Keep this in the  
file of this



Commonwealth of Virginia  
Uniform Water Well Completion Report

Name Norman Sullivan  
Address 4528 Queensbury Cr.  
FAB, VA 22408  
Phone \_\_\_\_\_  
Location 474 McCarty Rd.

Tax Map ID 59-18  
VDH Permit SWP-00-175  
VWCB Permit \_\_\_\_\_  
VWCB ID \_\_\_\_\_  
County Stafford

Well Classification IIIA \_\_\_\_\_ IIIB  IIIC \_\_\_\_\_ IV \_\_\_\_\_  
\* Well Data \*

General Information

Drilling Method AIR ROTARY  
Depth to Bedrock 90'  
Static Water Level 30'  
Well Disinfected (Y or N) N

Date Completed 10/20/00  
Yield 20+ (GPM)  
Stabilized Water Level \_\_\_\_\_  
Disinfectant Used \_\_\_\_\_

Total Depth of Well 160'  
Length of Test 1 hr.  
Natural Flow (Rate) N  
Amount Used \_\_\_\_\_

Casing From 1 1/2' To 128 1/2'  
Size 6 3/4" Material PVC  
Weight/Schedule 3.49 lb/ft.  
.250 WALL

From 100' To 120'  
Size 4.5" Material PVC  
Weight/Schedule 2.7 lb/ft.  
.250 WALL

From \_\_\_\_\_ To \_\_\_\_\_  
Size \_\_\_\_\_ Material \_\_\_\_\_  
Weight/Schedule \_\_\_\_\_

Gravel Pack

From \_\_\_\_\_ To \_\_\_\_\_

From \_\_\_\_\_ To \_\_\_\_\_

From \_\_\_\_\_ To \_\_\_\_\_

Hole size

" from \_\_\_\_\_ to \_\_\_\_\_ ft.

" from \_\_\_\_\_ to \_\_\_\_\_ ft.

" from \_\_\_\_\_ to \_\_\_\_\_ ft.

GUL

From 70' To 0

From 128 1/2' To 70'

From \_\_\_\_\_ To \_\_\_\_\_

Bore Hole Size 10" x 128 1/2'

Bore Hole Size 10" x 128 1/2'

Bore Hole Size \_\_\_\_\_

Type BENTONITE (E-Z SEAL)

Type SAND CUTTINGS

Type \_\_\_\_\_

Method press ure cement from bottom to top

Method Natural Pack Fill

Method \_\_\_\_\_

Water Zones or Screened Intervals

From 100' To 120'

From \_\_\_\_\_ To \_\_\_\_\_

From \_\_\_\_\_ To \_\_\_\_\_

Mesh Size .020 Diam 4.5"

Mesh Size \_\_\_\_\_ Diam \_\_\_\_\_

Mesh Size \_\_\_\_\_ Diam \_\_\_\_\_

From \_\_\_\_\_ To \_\_\_\_\_

From \_\_\_\_\_ To \_\_\_\_\_

From \_\_\_\_\_ To \_\_\_\_\_

Mesh Size \_\_\_\_\_ Diam \_\_\_\_\_

Mesh Size \_\_\_\_\_ Diam \_\_\_\_\_

Mesh Size \_\_\_\_\_ Diam \_\_\_\_\_

\* Use Data \*

Private Well: Domestic  Agricultural \_\_\_\_\_ Industrial \_\_\_\_\_ Monitoring \_\_\_\_\_  
Public Well: Community \_\_\_\_\_ Non Community \_\_\_\_\_

\* Abandonment Information \*

Bored or Bore Wells

Casing Removed, Y or N? \_\_\_\_\_

If Y, Depth in which casing was removed: \_\_\_\_\_

Depth and type of fill: \_\_\_\_\_

Source of fill: \_\_\_\_\_  
Aggregate: From \_\_\_\_\_ to \_\_\_\_\_ From \_\_\_\_\_ to \_\_\_\_\_

Wells other than Bored Wells

Casing removed, Y or N? \_\_\_\_\_

Depth to which casing was removed: \_\_\_\_\_

Applicable, depth(s), and type of gravel/sand fill: \_\_\_\_\_

Source of gravel or sand: \_\_\_\_\_  
Cement: From \_\_\_\_\_ to \_\_\_\_\_ From \_\_\_\_\_ to \_\_\_\_\_

Method of permanently marking location: \_\_\_\_\_

Installed watertight top


Dillers Log

Description of Formation or Sediment

NOT TO SCALE

Remarks

0	35'	brown sand
35'	90'	grey sandy clay
90'	152'	grey marine clay hard
152'	160'	brown coarse sand

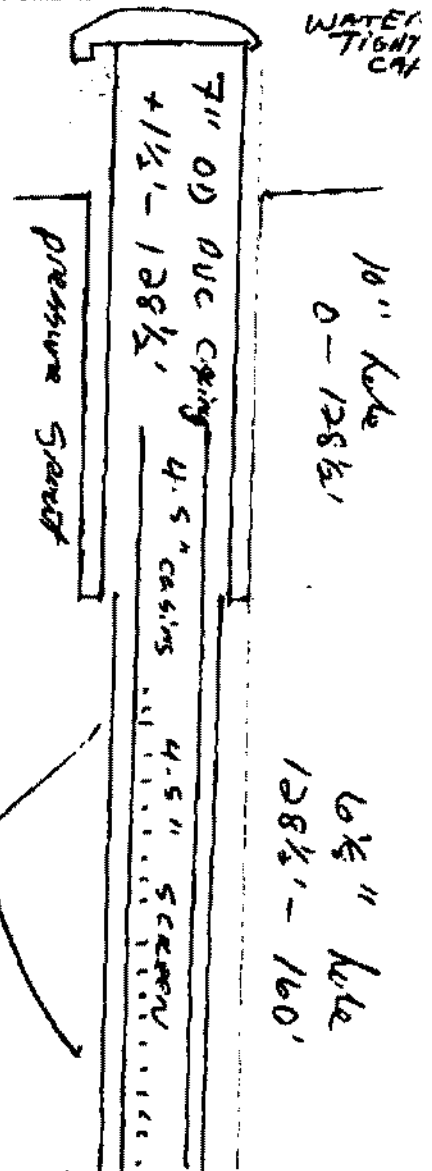

150'-160'  
20 GPH

(Use additional Sheets if necessary)

I certify that the information contained herein is true and that this well was installed and constructed in accordance with the permit and that the well complies with all applicable state and local regulations, ordinances and laws.

Company ARTESIAN WATER WELLS, INC.  
 Address 11412 GORDON RD  
PRINCE GEORGE VA 22407  
 Phone 540-295-8163

Diller's Signature Wesley A. Smith  
 Date 11/26/00 Representing A.W.W.I.

Diller's Contractors License Number 2705-046112