

Commonwealth of Virginia
Uniform Water Well Completion Report

Owner David Linda Crowley *Permit issued to:* Clifford Jaspici
 Address 1900 Pollock Street 191 Colebrook Rd
Manchester, Va. 22105 Manchester, Va. 22105
 Phone 373-3845 371-0214
 Location 191 Colebrook Rd/On left/approx 1 Mile E of Jerry Rd County Stafford
183C Approx 1 Mile E of Jerry Rd Colebrook Rd
 Well Classification IIIA IIIB IIIC IV
 Tax Map ID 59-26
 VDH Permit WS-92-282
 VWCB Permit _____
 VWCB ID _____
 8/9/92 Rob Snyder
 8/9/92 T.T. Thompson

* Well Data *

General Information Hand Rotary
 Drilling Method Hand Rotary
 Depth to Bedrock _____
 Static Water Level 5' 5/9/94
 Well Disinfected (Y or N) _____
 Date Completed 5/9/94
 Yield 60 (GPM)
 Stabilized Water Level 6.5'
 Disinfectant Used _____
 Total Depth of Well 160
 Length of Test approx 1 Hr
 Natural Flow (Rate) _____
 Amount Used _____

Casing
 From #1 To 84
 Size 6 3/4 Material P.V.C.
 Weight/Schedule SDR 27
 From 84 To 124
 Size 6 3/4 Material P.V.C.
 Weight/Schedule SDR 21
 From 115' to 130'
 From 150' To 160'
 Size 4 Material P.V.C.
 Weight/Schedule Sch. 40

Gravel Pack
 From _____ To _____
 Hole size 10" from 0 to 50 ft.
 Grout _____
 From 0 To 50 5/9/94
 Bore Hole Size 10"
 Type Bentonite
 Method Pressure Grouting
 From _____ To _____
 Hole size 7 1/8" from 50 to 124 ft.
 Grout _____
 From _____ To _____
 Bore Hole Size _____
 Type _____
 Method _____
 From _____ To _____
 Hole size 6 1/2" from 124 to 160 ft.
 Grout _____
 From _____ To _____
 Bore Hole Size _____
 Type _____
 Method _____

Water Zones or Screened Intervals
 From 130 To 150
 Mesh Size 020 Diam (P.V.C) 4"
 From _____ To _____
 Mesh Size _____ Diam _____
 From _____ To _____
 Mesh Size _____ Diam _____
* Use Data *

Private Well: Domestic Agricultural _____ Industrial _____ Monitoring _____
 Public Well: Community _____ Non Community _____

SN 94021950 5/6
1/2 H.P. 10 GPM Grand to 3 Sub.
WX 250 Tank

* Abandonment Information *

Bored or Dug Wells
 Casing Removed, Y or N? _____
 If Y, Depth to which casing was removed: _____
 Depth and Type of Fill: _____
 Source of Fill _____
 Bentonite Plugs: From _____ to _____ From _____ to _____
 Wells other than Bored Wells
 Casing removed, Y or N? _____
 Depth to which casing was removed: _____
 Applicable, depth(s), and type of gravel/sand fill: _____
 Source of gravel or sand: _____
 Cement: From _____ to _____ From _____ to _____


Method of permanently marking location:
 Installed watertight top
 Suggest setting pump @ approx. 85 ft.
you will encounter 4" casing @ approx 115'
Suggest keeping torque arrestors & centralizers out of 4" casing
933689
23 4083 Be Tank

State Department of Transportation
 Form 706-100-1
 11/79

Donald & Linda Crowley
191 Colebrook Rd.
Stafford
off Jerry Rd.

* Drillers Log *

Depth	Description of Formation or Sediment	Remarks
0	10	Sandy Red Clay
10	25	Sand & Gravel
25	60	Black Sand
60	70	Blue Marl
70	90	Sand & Gravel
90	125	Blue Clay
125	135	White Clay
135	150	Grey Sand
150	160	Blue Clay

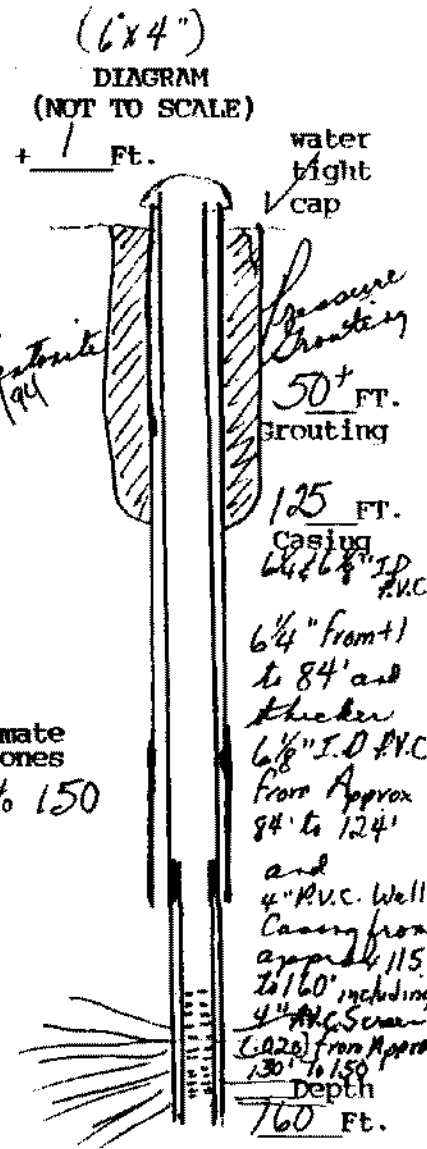

(User additional Sheets if necessary)

I certify that the information contained here is true and that this well was installed and constructed in accordance with the permit and further that the well complies with all applicable state and local regulations, ordinances and laws.

Name JOHN L. DANIELSON, JR., INC.
 Address 4616 HOOD DRIVE
FREDERICKSBURG, VIRGINIA 22408
 Phone (703) 898-6025 / 898-9355

Drillers Signature John L. Danielson, Jr.
 Date 5/9/94 Representing JOHN L. DANIELSON, JR., INC.

Virginia Contractors License Number CLASS A 2701 014084A H/H WWC