

94.76

2405-1711 Commonwealth of Virginia
Uniform Water Well Completion Report

Owner James Butler
Address 600 Crafts Street
Ladysburg, Va
Phone 371-7689
Location Leeward Sub #2 230 Hollywood Farm Rd

Tax Map ID 60-80B-2
VDH Permit SWP-01-638
VWCB Permit _____
VWCB ID _____
County Stafford
121st Ashby Luricht

Well Classification IIIA _____ IIIB IIIC _____ IV _____
* Well Data *

MR

General Information
Drilling Method Mud Rotary
Depth to Bedrock _____
Static Water Level 80'
Well Disinfected (Y or N) _____

Date Completed 11/22/02
Yield 30 (GPM)
Stabilized Water Level 180'
Disinfectant Used _____

Total Depth of Well 290'
Length of Test approx 1 hr
Natural Flow (Rate) _____
Amount Used _____

Casing From +1 To 260
Size 4 1/2" Material PVC
Weight/Schedule SDR 17

From 280 To 290
Size 4 1/2" Material PVC
Weight/Schedule SDR 17

From _____ To _____
Size _____ Material _____
Weight/Schedule _____

Gravel Pack From 60 To 290
Hole size _____
" from _____ to _____ ft.

From _____ To _____
" from _____ to _____ ft.

From _____ To _____
" from _____ to _____ ft.

Grout From 0 To 60
Bore Hole Size 2 1/2" 1 1/2"
Type Bentonite
Method Pressure Grouting

From _____ To _____
Bore Hole Size _____
Type _____
Method _____

From _____ To _____
Bore Hole Size _____
Type _____
Method _____

Water Zones or Screened Intervals
From 260 To 280
Mesh Size 20 Diam 4 1/2" (PVC)
From _____ To _____
Mesh Size _____ Diam _____

From _____ To _____
Mesh Size _____ Diam _____
* Use Data *

Private Well: Domestic Agricultural _____ Industrial _____ Monitoring _____
Public Well: Community _____ Non Community _____

* Abandonment Information *

Bored or Dug Wells
Casing Removed, Y or N? _____
If Y, Depth to which casing was removed: _____
Depth and Type of Fill: _____
Source of Fill _____
Bentonite Plugs: From _____ to _____ From _____ to _____

Wells other than Bored Wells
Casing removed, Y or N? _____
Depth to which casing was removed: _____
Applicable, depth(s), and type of gravel/sand fill: _____
Source of gravel or sand: _____
Cement: From _____ to _____ From _____ to _____

Method of permanently marking location: Installed watertight top
Suggest setting pump @ approx. 200 ft.


Butler
 Leonard Sub # 2
 Stafford
 220 Hollywood Farm Rd. * Drillers Log *
 Description of Formation or Sediment

Depth

Remarks

0	5	Brown clay
5	30	Sand & Gravel
30	50	Dark Gray Sandy Clay
50	165	Black Sand & Shells
165	185	Brown clay
185	200	Sandy Grey clay
200	208	Brown & Grey clay
208	210	Sandy Grey clay
210	280	Sand & Gravel
280	290	Grey clay

(4 1/2")
 DIAGRAM
 (NOT TO SCALE)

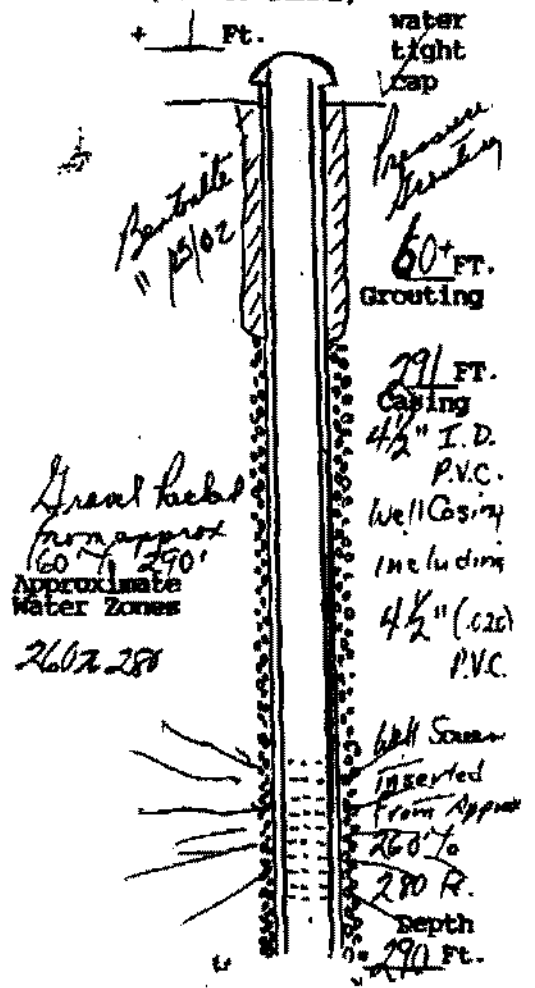

(Use additional Sheets if necessary)

I certify that the information contained here is true and that this well was installed and constructed in accordance with the permit and further that the well complies with all applicable state and local regulations, ordinances and laws.

Name JOHN L. DANIELSON, JR., INC.
 Address 4616 HOOD DRIVE
FREDERICKSBURG, VIRGINIA 22406
 Phone 540 (703) 898-6025 / 898-9355

Drillers Signature [Signature]
 Date 1/25/02 Representing JOHN L. DANIELSON, JR., INC.

Virginia Contractors License Number CLASS A 2701 014084A H/H WMC