

Commonwealth of Virginia
Uniform Water Well Completion Report

Person-Stephen Hatcher

60A 1-2

Box 1704

Grove, VA 22508

Plot #2 Riverbend

Tax Map ID

VDH-Permit SWP 94-449

WVCB Permit

WVCB ID

County Stafford

* Well Data *

General Information

Drilling Method Mud Rotary

Depth to Bedrock N/A

Static Water Level 96

Well Disinfected (Y or N) Y

Date Completed 2-24-95

Yield 30 (GPM)

Stabilized Water Level

Disinfectant Used Gran chlor

Total Depth of Well 193

Length of Test 4 hr

Natural Flow (Rate)

Amount Used 2 cups

Casing

From +1 to 193

Size 4 1/2 Material PVC

Weight/Schedule Sch 40

From _____ to _____

Size _____ Material _____

Weight/Schedule _____

From _____ to _____

Size _____ Material _____

Weight/Schedule _____

Gravel Pack

From 193 to 50

From _____ to _____

From _____ to _____

Grout

From 50 to 0

Bore Hole Size 8"

Type Neat

Method Pressure

From _____ to _____

Bore Hole Size _____

Type _____

Method _____

From _____ to _____

Bore Hole Size _____

Type _____

Method _____

Water Zones or Screened Intervals

From 165 to 185

Mesh Size 0.020 Diam. 4 1/2

From 165 to 185

Mesh Size _____ Diam. _____

From _____ to _____

Mesh Size _____ Diam. _____

From _____ to _____

Mesh Size _____ Diam. _____

From _____ to _____

Mesh Size _____ Diam. _____

From _____ to _____

Mesh Size _____ Diam. _____

* Use Data *

Private Well:

Domestic X

Agricultural _____

Industrial _____

Monitoring _____

Public Well:

Community _____

Non Community _____

Depth


Description of Formation or Sediment

ateme

Virginia
Department of Health
Name of Company/Corporation/In
Address: 525 Cass...
Rox...

0-15	Red clay
15-35	Gravel
35-100	Clay
100-145	Clay
145-165	Clay
165-185	Sand & gravel
185-193	Clay

Large
Green
Blue
gray
Brown, soft
Gray, coarse
Water bearing
Blue

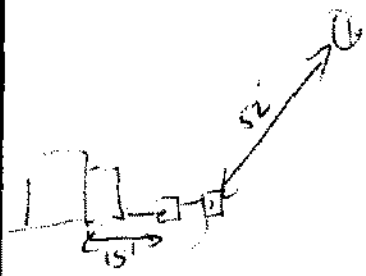

Alarm 18
July 20

I certify that the information contained here is true and that this well was installed and constructed in accordance with the permit and further that the well complies with all applicable state laws regulations, ordinances and laws.

Drilling Contractor VAN'S CONSTRUCTION CO., INC.
 Address P.O. BOX 3306
FREDERICKSBURG, VIRGINIA 22402
 Phone (703) 373-7502

Drillers Signature *Jeff Taylor* Date 2-24-95
 Representing VAN'S CONSTRUCTION CO., INC.
 Virginia Contractors License Number 2701 018610A