

**Commonwealth of Virginia  
Uniform Water Well Completion Report**

James  
Long Court  
Richmond, Va. 22405  
1119 F 899-9115

Owner Lepton Signature James / For Sale  
Address \_\_\_\_\_  
Phone 899-9889  
Location Rivers Bend Sect 1 - Lot 6 (204 Old Landing Court)  
Well Classification IIIA IIIB IIIC IV  
**\* Well Data \***

Tax Map ID 60A-1-16  
VDH Permit SUP-95-324  
VWCB Permit \_\_\_\_\_  
VWCB ID \_\_\_\_\_  
County STAFFORD  
10/12/95 David J. ...  
DGI

**General Information**  
Drilling Method Mod Rotary Date Completed 3/1/96 Total Depth of Well 159'  
Depth to Bedrock \_\_\_\_\_ Yield 30 (GPM) Length of Test approx 2 Hrs  
Static Water Level 20' Stabilized Water Level 60' Natural Flow (Rate) \_\_\_\_\_  
Well Disinfected (Y or N) \_\_\_\_\_ Disinfectant Used \_\_\_\_\_ Amount Used \_\_\_\_\_

**Casing**  
From 1 To 129 From 149 To 159 From \_\_\_\_\_ To \_\_\_\_\_  
Size 4 1/2 Material P.V.C. Size 4 1/2 Material P.V.C. Size \_\_\_\_\_ Material \_\_\_\_\_  
Weight/Schedule SDR 17 Weight/Schedule SDR 17 Weight/Schedule \_\_\_\_\_

**Gravel Pack**  
From 50 To 159 From \_\_\_\_\_ To \_\_\_\_\_ From \_\_\_\_\_ To \_\_\_\_\_  
**Hole size**  
7 1/8" from 0 to 159 ft. " from \_\_\_\_\_ to \_\_\_\_\_ ft.  
**Grout**  
From 0 To 50" From \_\_\_\_\_ To \_\_\_\_\_ From \_\_\_\_\_ To \_\_\_\_\_  
Bore Hole Size 7 1/8" Bore Hole Size \_\_\_\_\_ Bore Hole Size \_\_\_\_\_  
Type Bentonite Type \_\_\_\_\_ Type \_\_\_\_\_  
Method Pressure Grouting Method \_\_\_\_\_ Method \_\_\_\_\_

**Water Zones or Screened Intervals**  
From 129 To 149 From 125' To 156' From \_\_\_\_\_ To \_\_\_\_\_  
Mesh Size 20 Diam 4 1/2" (P.V.C.) Mesh Size \_\_\_\_\_ Diam \_\_\_\_\_ Mesh Size \_\_\_\_\_ Diam \_\_\_\_\_  
From \_\_\_\_\_ To \_\_\_\_\_ From \_\_\_\_\_ To \_\_\_\_\_ From \_\_\_\_\_ To \_\_\_\_\_  
Mesh Size \_\_\_\_\_ Diam \_\_\_\_\_ Mesh Size \_\_\_\_\_ Diam \_\_\_\_\_ Mesh Size \_\_\_\_\_ Diam \_\_\_\_\_

**\* Use Data \***

Private Well: Domestic  Agricultural \_\_\_\_\_ Industrial \_\_\_\_\_ Monitoring \_\_\_\_\_  
Public Well: Community \_\_\_\_\_ Non Community \_\_\_\_\_

**\* Abandonment Information \***

**Bored or Dug Wells**  
Casing Removed, Y or N? \_\_\_\_\_  
If Y, Depth to which casing was removed: \_\_\_\_\_  
Depth and Type of Fill: \_\_\_\_\_  
Source of Fill \_\_\_\_\_  
Bentonite Plugs: From \_\_\_\_\_ to \_\_\_\_\_ From \_\_\_\_\_ to \_\_\_\_\_



**Wells other than Bored Wells**  
Casing removed, Y or N? \_\_\_\_\_  
Depth to which casing was removed: \_\_\_\_\_  
Applicable, depth(s), and type of gravel/sand fill: \_\_\_\_\_  
Source of gravel or sand: \_\_\_\_\_  
Cement: From \_\_\_\_\_ to \_\_\_\_\_ From \_\_\_\_\_ to \_\_\_\_\_

Method of permanently marking location: \_\_\_\_\_  
 Installed watertight top  
Suggest setting pump @ approx. 80 ft.

Attest  
 Agent of Virginia  
 Company/Co.

Person Signature/Notes  
River Bend #6 / For Sale  
204 Old Landing Court  
Stafford off SE #1410 Drillers Log

Depth	Description of Formation or Sediment	Remarks
0 15	Sand & Gravel	
15 25	Grey Sand & Clay	
25 110	Black Sand & Shells	
110 125	Grey Sandy Clay	
125 156	Grey Sand	
156 159	Sandy Grey Clay	

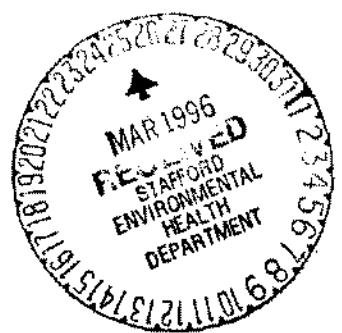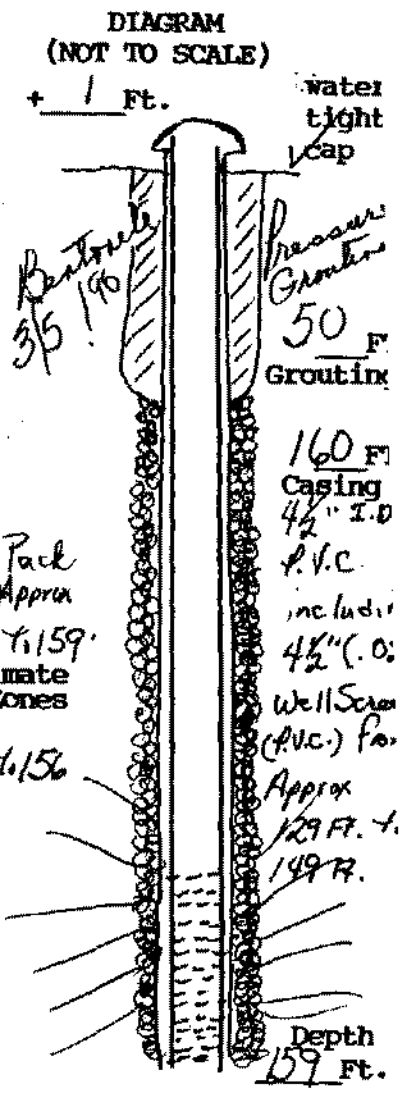

(User additional Sheets if necessary)

I certify that the information contained here is true and that this well was installed and constructed in accordance with the permit and further that the well complies with all applicable state and local regulations, ordinances and laws.

Name JOHN L. DANIELSON, JR., INC.  
 Address 4616 HOOD DRIVE  
FREDERICKSBURG, VIRGINIA 22408  
 Phone 540 (703) 898-6025 / 898-9355

Drillers Signature John L. Danielson, Jr.  
 Date 3/5/96 Representing JOHN L. DANIELSON, JR., INC.

Virginia Contractors License Number CLASS A 2701 014084A H/H WWC