

**Commonwealth of Virginia
Uniform Water Well Completion Report**

Owner Barry Ross
 Address 6 Chapel Court
Fredricksburg, Va. 22405
 Phone 371-6074
 Location 240 Chapel Street Rd - (602 off #218)

Tax Map ID 60-62A
 VDH Permit SW-94-469
 VWCB Permit _____
 VWCB ID _____
 County Stafford
12/6/94 Arthur B. Wright

Well Classification IIIA IIIB / IIIC IV
approx 2 Miles from Fredericksburg of 281602 • Well Data •
5/8 Miles South of 602

SGK/ILD

General Information

Drilling Method Mud Rotary Date Completed 5/9/95 Total Depth of Well 305
 Depth to Bedrock _____ Yield 40 (GPM) Length of Test approx 1 Hr.
 Static Water Level approx 80' Stabilized Water Level 160' Natural Flow (Rate) _____
 Well Disinfected (Y or N) _____ Disinfectant Used _____ Amount Used _____

Casing

From <u>+1</u> To <u>235</u>	From <u>225</u> To <u>290</u>	From <u>300</u> To <u>305</u>
Size <u>4 1/2" Material P.V.C.</u>	Size <u>2" Material galv. steel</u>	Size <u>2" Material galvanized steel</u>
Weight/Schedule <u>SDR 17</u>	Weight/Schedule <u>Schedule 40</u>	Weight/Schedule <u>schedule 40</u>

Gravel Pack

From _____ To _____ From _____ To _____ From _____ To _____

Hole size

7 7/8" from 40 to 235 ft. 3 1/8" from 235 to 305 ft.

Grout

From <u>0</u> To <u>50' ft</u>	From _____ To _____	From _____ To _____
Bore Hole Size <u>10"</u>	Bore Hole Size _____	Bore Hole Size _____
Type <u>Bentonite</u>	Type _____	Type _____
Method <u>Pressure Grouting</u>	Method _____	Method _____

Water Zones or Screened Intervals

From <u>290'</u> To <u>300'</u>	From <u>290'</u> To <u>300'</u>	From _____ To _____
Mesh Size <u>.020</u> Diam <u>2" Span Loss</u>	Mesh Size _____ Diam _____	Mesh Size _____ Diam _____
From _____ To _____	From _____ To _____	From _____ To _____
Mesh Size _____ Diam _____	Mesh Size _____ Diam _____	Mesh Size _____ Diam _____

*** Use Data ***

Private Well: Domestic Agricultural _____ Industrial _____ Monitoring _____
 Public Well: Community _____ Non Community _____

*** Abandonment Information ***

Bored or Dug Wells

Casing Removed, Y or N? _____
 If Y, Depth to which casing was removed: _____
 Depth and Type of Fill: _____
 Source of Fill _____
 Bentonite Plugs: From _____ to _____ From _____ to _____

Wells other than Bored Wells

Casing removed, Y or N? _____
 Depth to which casing was removed: _____
 Applicable, depth(s), and type of gravel/sand fill: _____
 Source of gravel or sand: _____
 Cement: From _____ to _____ From _____ to _____

Method of permanently marking location:

Installed watertight top
 Suggest setting pump @ approx. 180 ft. (Well pumped 20 G.P.M. @ 180' on 5/9/95)


ADVANCED

Barry Ross
Stafford 602 off 218
240 Chapel Green Road

Drillers Log

Depth	Description of Formation or Sediment
0	30 yellow sand
30	40 Red Clay
40	120 Black Sand & Shells
120	130 Gray clay
130	220 Black Sand & Shells
220	230 Sandy Gray clay
230	255 Brown clay
255	280 Sandy grey clay
280	302 Sandstone with layers of sand & gravel
302	305 Brown clay

Remarks

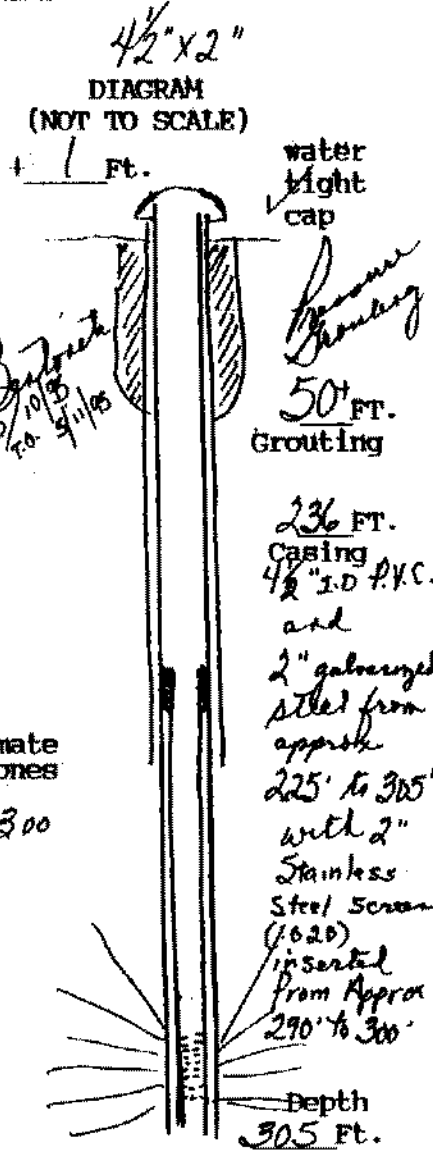

(User additional Sheets if necessary)

I certify that the information contained here is true and that this well was installed and constructed in accordance with the permit and further that the well complies with all applicable state and local regulations, ordinances and laws.

Name JOHN L. DANIELSON, JR., INC.
Address 4616 HOOD DRIVE
FREDERICKSBURG, VIRGINIA 22408
Phone (703) 898-6025 / 898-9355

Drillers Signature John L. Danielson, Pres
Date 5/11/83 Representing JOHN L. DANIELSON, JR., INC.

Virginia Contractors License Number CLASS A 2701 014084A H/H WNC