

Commonwealth of Virginia

Uniform Water Well Completion Report

Owner Permit issued to Russell Sullivan / For Sale  
Address 6 White Oak Rd  
2 Burg Co. 22405  
Phone 373-18840  
Location 602 off 218

Tax Map ID 60-63 66  
VDH Permit WS-93 360  
VWCB Permit \_\_\_\_\_  
VWCB ID \_\_\_\_\_  
County Stafford

Well Classification IIIA IIIB  IIIC IV  
\* Well Data \*

General Information  
Drilling Method Rotary Date Completed 6/30/94 Total Depth of Well 320  
Depth to Bedrock \_\_\_\_\_ Yield 10 (GPM) Length of Test approx 3 hrs.  
Static Water Level approx 60' Stabilized Water Level 77.80 Natural Flow (Rate) \_\_\_\_\_  
Well Disinfected (Y or N) \_\_\_\_\_ Disinfectant Used \_\_\_\_\_ Amount Used \_\_\_\_\_

Casing  
From ± 1 To 220 From 204 To 309 From \_\_\_\_\_ To \_\_\_\_\_  
Size 4 1/2" Material P.V.C. Size 2" Material galv. steel Size \_\_\_\_\_ Material \_\_\_\_\_  
Weight/Schedule SDR 17 Weight/Schedule 56L-40 Weight/Schedule \_\_\_\_\_

Gravel Pack  
From \_\_\_\_\_ To \_\_\_\_\_ From \_\_\_\_\_ To \_\_\_\_\_ From \_\_\_\_\_ To \_\_\_\_\_  
Hole size \_\_\_\_\_ " from \_\_\_\_\_ to \_\_\_\_\_ ft. 4" from 220 to 320 ft. \_\_\_\_\_ " from \_\_\_\_\_ to \_\_\_\_\_ ft.  
Grout From 0 To 50' From \_\_\_\_\_ To \_\_\_\_\_ From \_\_\_\_\_ To \_\_\_\_\_  
Bore Hole Size 1 1/8 Bore Hole Size \_\_\_\_\_ Bore Hole Size \_\_\_\_\_  
Type Bentonite Type \_\_\_\_\_ Type \_\_\_\_\_  
Method pressure grouting Method \_\_\_\_\_ Method \_\_\_\_\_

Water Zones or Screened Intervals  
From 309 To 320 From 302 To 320 From \_\_\_\_\_ To \_\_\_\_\_  
Mesh Size 20 Diam 2" stainless steel Mesh Size \_\_\_\_\_ Diam \_\_\_\_\_ Mesh Size \_\_\_\_\_ Diam \_\_\_\_\_  
From \_\_\_\_\_ To \_\_\_\_\_ From \_\_\_\_\_ To \_\_\_\_\_ From \_\_\_\_\_ To \_\_\_\_\_  
Mesh Size \_\_\_\_\_ Diam \_\_\_\_\_ Mesh Size \_\_\_\_\_ Diam \_\_\_\_\_ Mesh Size \_\_\_\_\_ Diam \_\_\_\_\_

\* Use Data \*  
Private Well: Domestic  Agricultural \_\_\_\_\_ Industrial \_\_\_\_\_ Monitoring \_\_\_\_\_  
Public Well: Community \_\_\_\_\_ Non Community \_\_\_\_\_

\* Abandonment Information \*  
Bored or Dug Wells Wells other than Bored Wells  
Casing Removed, Y or N? \_\_\_\_\_ Casing removed, Y or N? \_\_\_\_\_  
If Y, Depth to which casing was removed: \_\_\_\_\_ Depth to which casing was removed: \_\_\_\_\_  
Depth and Type of Fill: \_\_\_\_\_ Applicable, depth(s), and type of gravel/sand fill: \_\_\_\_\_  
Source of Fill Source of gravel or sand: \_\_\_\_\_  
Bentonite Plugs: From \_\_\_\_\_ to \_\_\_\_\_ From \_\_\_\_\_ to \_\_\_\_\_ Cement: From \_\_\_\_\_ to \_\_\_\_\_ From \_\_\_\_\_ to \_\_\_\_\_

Method of permanently marking location:  
 Installed watertight top  
Suggest setting pump @ approx. 200 ft.  
Well telescoped to 2" @ approx. 204'



Larry R. Sullivan  
1602

Slafford off 218

Drillers Log

Depth Description of Formation or Sediment


Remarks

4 1/2" x 2"

DIAGRAM (NOT TO SCALE)

+ 1 Ft.

water tight cap

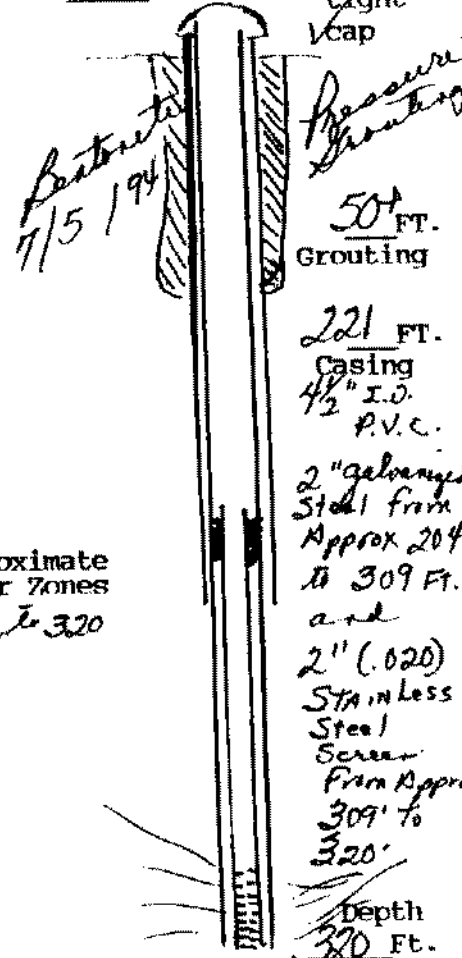

Approximate Water Zones  
302 to 320

0	20	yellow sandy clay
20	30	Red clay
30	110	Black Sand & Shells
110	120	Grey clay
120	210	Black Sand & Shells
210	240	Grey Sandy clay
240	280	Grey & Brown Clay
280	302	Sandy Grey clay
302	320	Grey Sand

(Use additional Sheets if necessary)

I certify that the information contained here is true and that this well was installed and constructed in accordance with the permit and further that the well complies with all applicable state and local regulations, ordinances and laws.

Name JOHN L. DANIELSON, JR., INC.  
Address 4616 HOOD DRIVE  
FREDERICKSBURG, VIRGINIA 22408  
Phone (703) 898-6025 / 808-9355

Drillers Signature [Signature]  
Date 7/5/94 Representing JOHN L. DANIELSON, JR., INC.

Virginia Contractors License Number CLASS A 2701 014084A H/H WWC

150 C OLDE GREENBRIER 9116