

**Commonwealth of Virginia
Uniform Water Well Completion Report**

Homes
76-22555
7678

Address Crown Classic Homes / For Sale
P.O. Box 861
Stafford, Va. 22555
Phone 659-2878
Location Rever Bend #4 (Old Landing Court)
off #3

Tax Map ID 60A-4
VDH Permit W5-94-52
VWCB Permit _____
VWCB ID _____
County Stafford

Well Classification IIIA IIIB IIIC IV
2/16/94 Castle B. Wright
2/17/94 J J Thompson
* Well Data *

General Information

Drilling Method And Rotary Date Completed 7/6/94 Total Depth of Well 170'
Depth to Bedrock _____ Yield 15 (GPM) Length of Test approx 3 Hrs
Static Water Level approx 60' Stabilized Water Level approx 100' Natural Flow (Rate) _____
Well Disinfected (Y or N) _____ Disinfectant Used _____ Amount Used _____

Casing From +1 To 145 From 165 To 170 From _____ To _____
Size 4 1/2" Material P.V.C. Size 4 1/2" Material P.V.C. Size _____ Material _____
Weight/Schedule SDR 17 Weight/Schedule SDR 22 Weight/Schedule _____

Gravel Pack From 60 To 170 From _____ To _____ From _____ To _____
Hole size 7 7/8" from 0 to 170 ft. " from _____ to _____ ft. " from _____ to _____ ft.
Grout From 0 To 55' From _____ To _____ From _____ To _____
Bore Hole Size 7 7/8" Bore Hole Size _____ Bore Hole Size _____
Type Bentonite Type _____ Type _____
Method Pressure Grouting Method _____ Method _____

Water Zones of Screened Intervals approx water zone
From 145 To 165 From 138' To 167' From _____ To _____
Mesh Size .020 Diam 4 1/2" P.V.C. Mesh Size _____ Diam _____ Mesh Size _____ Diam _____
From _____ To _____ From _____ To _____ From _____ To _____
Mesh Size _____ Diam _____ Mesh Size _____ Diam _____ Mesh Size _____ Diam _____

* Use Data *

Private Well: Domestic Agricultural _____ Industrial _____ Monitoring _____
Public Well: Community _____ Non Community _____

* Abandonment Information *

Bored or Dug Wells
Casing Removed, Y or N?: _____
If Y, Depth to which casing was removed: _____
Depth and Type of Fill: _____
Source of Fill: _____
Bentonite Plugs: From _____ to _____ From _____ to _____
Method of permanently marking location: _____
 Installed watertight top 140 ft.
Suggest setting pump @ approx. _____ ft.

Wells other than Bored Wells
Casing removed, Y or N? _____
Depth to which casing was removed: _____
Applicable, depth(s), and type of gravel/sand fill: _____
Source of gravel or sand: _____
Cement: From _____ to _____ From _____ to _____



Crown Classic Homes
River Bend #4
Stafford


34661
 Old Landing Court • Drillers Log
 on Rappahannock River

Depth

Description of Formation or Sediment

Remarks

0	2	Topsoil
2	30	Sand & Gravel
30	35	Grey Clays
35	110	Black sand
110	130	Brown & Grey Clay
130	138	Sandy Clay
138	167	Grey sand - Water Zone
167	170	Grey clay

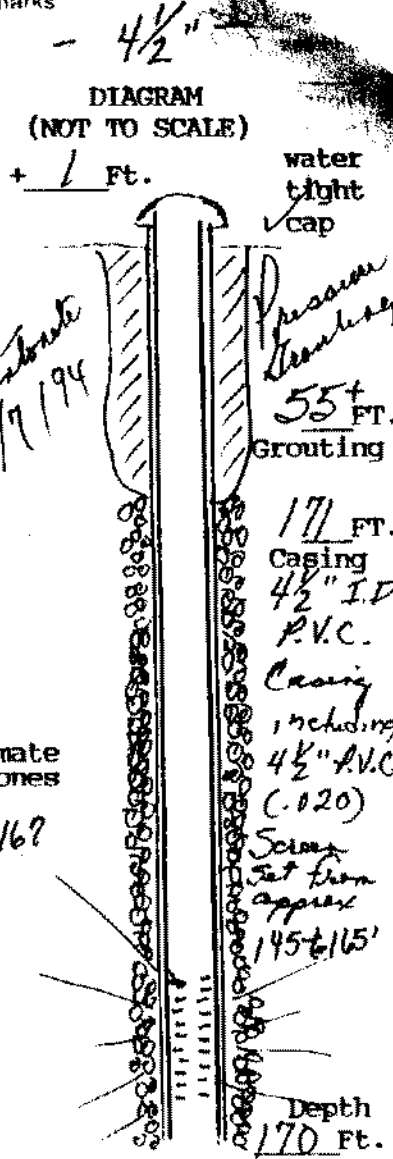

(User additional Sheets if necessary)

I certify that the information contained here is true and that this well was installed and constructed in accordance with the permit and further that the well complies with all applicable state and local regulations, ordinances and laws.

Name JOHN L. DANIELSON, JR., INC.
 Address 4616 HOOD DRIVE
FREDERICKSBURG, VIRGINIA 22408
 Phone (703) 898-6625 / 898-9355

Drillers Signature John L. Danielson, Jr.
 Date 7/7/94 representing JOHN L. DANIELSON, JR., INC.

Virginia Contractors License Number CLASS A 2701 014084A H/H WWC

ANITIC LABORATORY
 State Certified
 Environmental Lab
 1715 10th St. #200
 Fairfax, VA 22031
 Tel: 703-271-0000