

W. Carlson  
202 Old Landing Court  
Fredericksburg, VA 22405  
899-9115

Commonwealth of Virginia  
Uniform Water Well Completion Report

Owner Carlson Homes / For Sale  
Address 202 Old Landing Court  
Fredericksburg, VA 22405  
899-67889  
Location River Bend #1

Tax Map ID 60A-1  
VDH Permit WS-94-53  
VWCB Permit \_\_\_\_\_  
VWCB ID \_\_\_\_\_  
County STAFFORD  
2/16/97 Patton Wright  
2/17/97 J.D. Thompson  
CRC

Well Classification IIIA \_\_\_\_\_ IIIB  IIIC \_\_\_\_\_ IV \_\_\_\_\_  
\* Well Data \*

General Information

Drilling Method Mud Rotary  
Depth to Bedrock \_\_\_\_\_  
Static Water Level 50  
Well Disinfected (Y or N) \_\_\_\_\_

Date Completed 11/14/97  
Yield 60 (GPM)  
Stabilized Water Level \_\_\_\_\_  
Disinfectant Used \_\_\_\_\_

Total Depth of Well 168'  
Length of Test \_\_\_\_\_  
Natural Flow (Rate) \_\_\_\_\_  
Amount Used \_\_\_\_\_

Casing

From #1 To 140  
Size 4 1/2 Material P.V.C.  
Weight/Schedule SDR 17

From 160 To 168  
Size 4 1/2 Material P.V.C.  
Weight/Schedule SDR 17

From \_\_\_\_\_ To \_\_\_\_\_  
Size \_\_\_\_\_ Material \_\_\_\_\_  
Weight/Schedule \_\_\_\_\_

Gravel Pack

From 50 To 168

From 1 To \_\_\_\_\_

From \_\_\_\_\_ To \_\_\_\_\_

Hole size

7 7/8 from 0 to 168 ft.

\_\_\_\_\_ " from \_\_\_\_\_ to \_\_\_\_\_ ft.

\_\_\_\_\_ " from \_\_\_\_\_ to \_\_\_\_\_ ft.

Grout

From 0 To 50' 11/17/97

From \_\_\_\_\_ To \_\_\_\_\_

From \_\_\_\_\_ To \_\_\_\_\_

Bore Hole Size

7 7/8

Bore Hole Size

\_\_\_\_\_

Bore Hole Size

\_\_\_\_\_

Type

Bentonite

Type

\_\_\_\_\_

Type

\_\_\_\_\_

Method

Pressure Grouting

Method

\_\_\_\_\_

Method

\_\_\_\_\_

Water Zones or Screened Intervals

From 140 To 160  
Mesh Size .020 Diam 4 1/2" (P.V.C.)

approx water zone  
From 140 To 160  
Mesh Size \_\_\_\_\_ Diam \_\_\_\_\_

From \_\_\_\_\_ To \_\_\_\_\_  
Mesh Size \_\_\_\_\_ Diam \_\_\_\_\_

\* Use Data \*

Private Well: Domestic  Agricultural \_\_\_\_\_ Industrial \_\_\_\_\_ Monitoring \_\_\_\_\_  
Public Well: Community \_\_\_\_\_ Non Community \_\_\_\_\_

11/17  
3/4 H.P. 10 GPM STA. Rate  
STAINLESS STEEL Sub.  
W X 250 Tank

\* Abandonment Information \*

Bored or Dug Wells

Casing Removed, Y or N? \_\_\_\_\_  
If Y, Depth to which casing was removed: \_\_\_\_\_  
Depth and Type of Fill: \_\_\_\_\_  
Source of Fill: \_\_\_\_\_  
Bentonite Plugs: From \_\_\_\_\_ to \_\_\_\_\_ From \_\_\_\_\_ to \_\_\_\_\_

Wells other than Bored Wells

Casing removed, Y or N? \_\_\_\_\_  
Depth to which casing was removed: \_\_\_\_\_  
Applicable, depth(s), and type of gravel/sand fill: \_\_\_\_\_  
Source of gravel or sand: \_\_\_\_\_  
Cement: From \_\_\_\_\_ to \_\_\_\_\_ From \_\_\_\_\_ to \_\_\_\_\_

Method of permanently marking location:


Installed watertight top  
Suggest setting pump @ approx 100 ft.

Roy H. Carlson  
 Combined Inc  
 River Bend # 1  
 Stafford  
 Old Landing Court  
 off SE.

\* Drillers Log \*

Depth	Description of Formation or Sediment	Remarks
0	30	Sand & Gravel
30	110	Black Sand
110	130	Brown Clay
130	140	Sandy Grey Clay
140	160	Grey Sand - Water zone
160	168	Grey Clay

DIAGRAM  
 (NOT TO SCALE)  
 + 1 Ft.

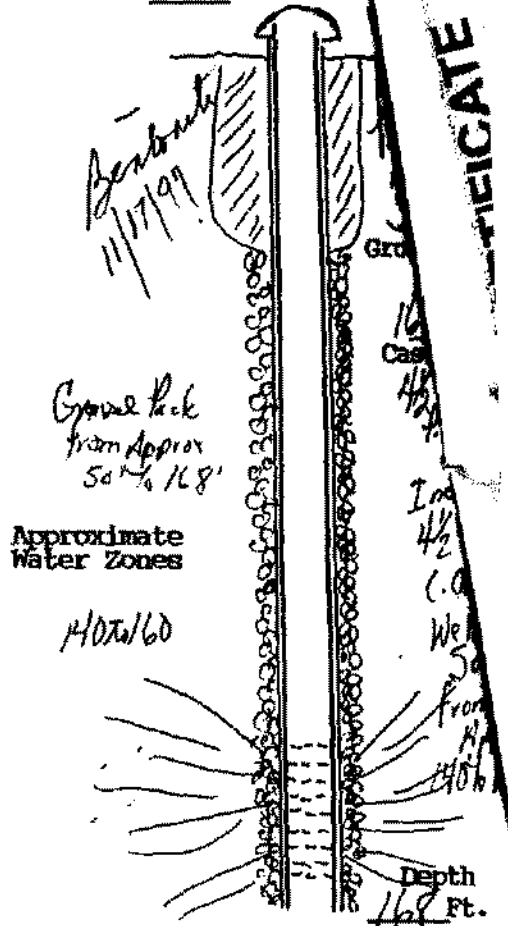

(User additional Sheets if necessary)

I certify that the information contained here is true and that this well was installed and constructed in accordance with the permit and further that the well complies with all applicable state and local regulations, ordinances and laws.

Name JOHN L. DANIELSON, JR., INC.  
 Address 4616 HOOD DRIVE  
FREDERICKSBURG, VIRGINIA 22408  
 Phone 570 (783) 898-6025 / 898-9355

Drillers Signature Roy H. Carlson, Pres.  
 Date 11/17/97 Representing JOHN L. DANIELSON, JR., INC.

Virginia Contractors License Number CLASS A 2701 014084A H/H WNC