

Pure Homes
 1088 F 720-1091 1-372-0954 M 840-9802
 814-9115
 22554 Uniform Water Well Completion Report

Address P.O. Box 861
Stafford Va 22554
 Phone 659-7878
 Location Riverside Sect 1 Lot 3 (3E) (Old landing (cont))

Tax Map ID 60A-3
 VDH Permit WS-94-68
 VWCB Permit _____
 VWCB ID _____
 County Stafford
2/16/95 Ashton Wright
4/7/95 J.P. Thompson
SFF

Well Classification IIIA _____ IIIB IIIIC _____ IV _____
 * Well Data *

General Information
 Drilling Method Mud Rotary
 Depth to Bedrock _____
 Static Water Level approx 20'
 Well Disinfected (Y or N) _____

Date Completed 9/20/95
 Yield 30 (GPM)
 Stabilized Water Level approx 80'
 Disinfectant Used _____

Total Depth of Well 170'
 Length of Test approx 1 HR.
 Natural Flow (Rate) _____
 Amount Used _____

Casing
 From 7 1/2 To 140
 Size 4 1/2 Material P.V.C.
 Weight/Schedule SDR 17

From 160 To 170
 Size 4 1/2 Material P.V.C.
 Weight/Schedule SDR 17

From _____ To _____
 Size _____ Material _____
 Weight/Schedule _____

Gravel Pack
 From 30 To 170

From _____ To _____

From _____ To _____

Hole size
7 1/2" From 0 to 170 ft.

" from _____ to _____ ft.

" from _____ to _____ ft.

Grout
 From 0 To 50'
 Bore Hole Size 7 1/8 9/20/95
 Type Bentonite
 Method Pressure Grouting

From _____ To _____
 Bore Hole Size _____
 Type _____
 Method _____

From _____ To _____
 Bore Hole Size _____
 Type _____
 Method _____

Water Zones or Screened Intervals
 From 140 To 160
 Mesh Size 20 Diam 9 1/2" (P.V.C.)

approx water zone
 From 142 To 158
 Mesh Size _____ Diam _____

From _____ To _____
 Mesh Size _____ Diam _____

* Use Data *

Private Well: Domestic Agricultural _____ Industrial _____ Monitoring _____
 Public Well: Community _____ Non Community _____

9/21
3/4 H.P. 10 GPM Red Jacket
Submersible
Serial # Pump - 0386559
Motor - 0386558
WX 250 Tank

* Abandonment Information *

Bored or Dug Wells
 Casing Removed, Y or N? _____
 If Y, Depth to which casing was removed: _____
 Depth and Type of Fill: _____
 Source of Fill _____
 Bentonite Plugs: From _____ to _____ From _____ to _____

Wells other than Bored Wells
 Casing removed, Y or N? _____
 Depth to which casing was removed: _____
 Applicable, depth(s), and type of gravel/sand fill: _____
 Source of gravel or sand: _____
 Cement: From _____ to _____ From _____ to _____

Method of permanently marking location:
 Installed watertight top
 Suggest setting pump @ approx. 100 ft.


951792

Louis Peyton
 Peyton Signature Homes
 River Bend #3 (For Sale)
 Stafford

#3 East → Reverted Drive → Old Landing Court
 Drillers Log

Depth Description of Formation or Sediment Remarks

0	10	Sandy Red Clay
10	15	yellow sand
15	60	Blue Marl
60	130	Black Sand
130	142	Blue Clay
142	158	Grey Sand
158	170	Brown Clay

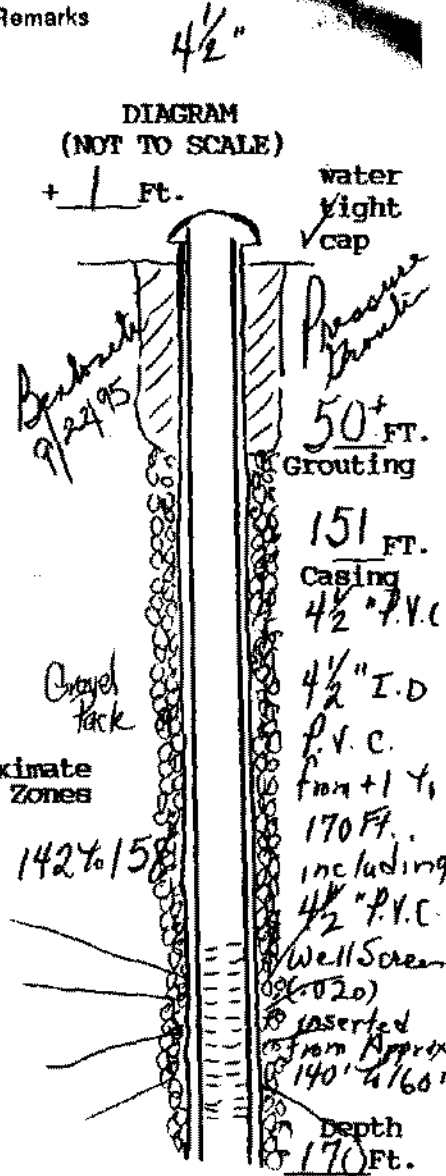

(User additional Sheets if necessary)

I certify that the information contained here is true and that this well was installed and constructed in accordance with the permit and further that the well complies with all applicable state and local regulations, ordinances and laws.

Name JOHN L. DANIELSON, JR., INC.
 Address 4616 HOOD DRIVE
FREDERICKSBURG, VIRGINIA 22408
 Phone (703) 898-6025 / 898-9355

Drillers Signature John L. Danielson, Pres.
 Date 9/24/95 Representing JOHN L. DANIELSON, JR., INC.

Virginia Contractors License Number CLASS A 2701 014084A H/H WWC